

SURVEY FOR OTTO W. HEIDER

PART OF THE JAMES B. GRAVES D.L.C. No. 42
 Sec. 34 Tp. 5 S. R. 6 W. WM. YAMHILL COUNTY
 BEARINGS FROM GREEN ACRES SUBDIVISION FEB 10, 1967


RECEIVED
 FEB 9 1967
 STATE ENGINEER
 S. W. JOHNSON

53107
 38589

● DENOTES IRON PIPES FOUND

○ DENOTES IRON RODS SET

SCALE 1" = 100'

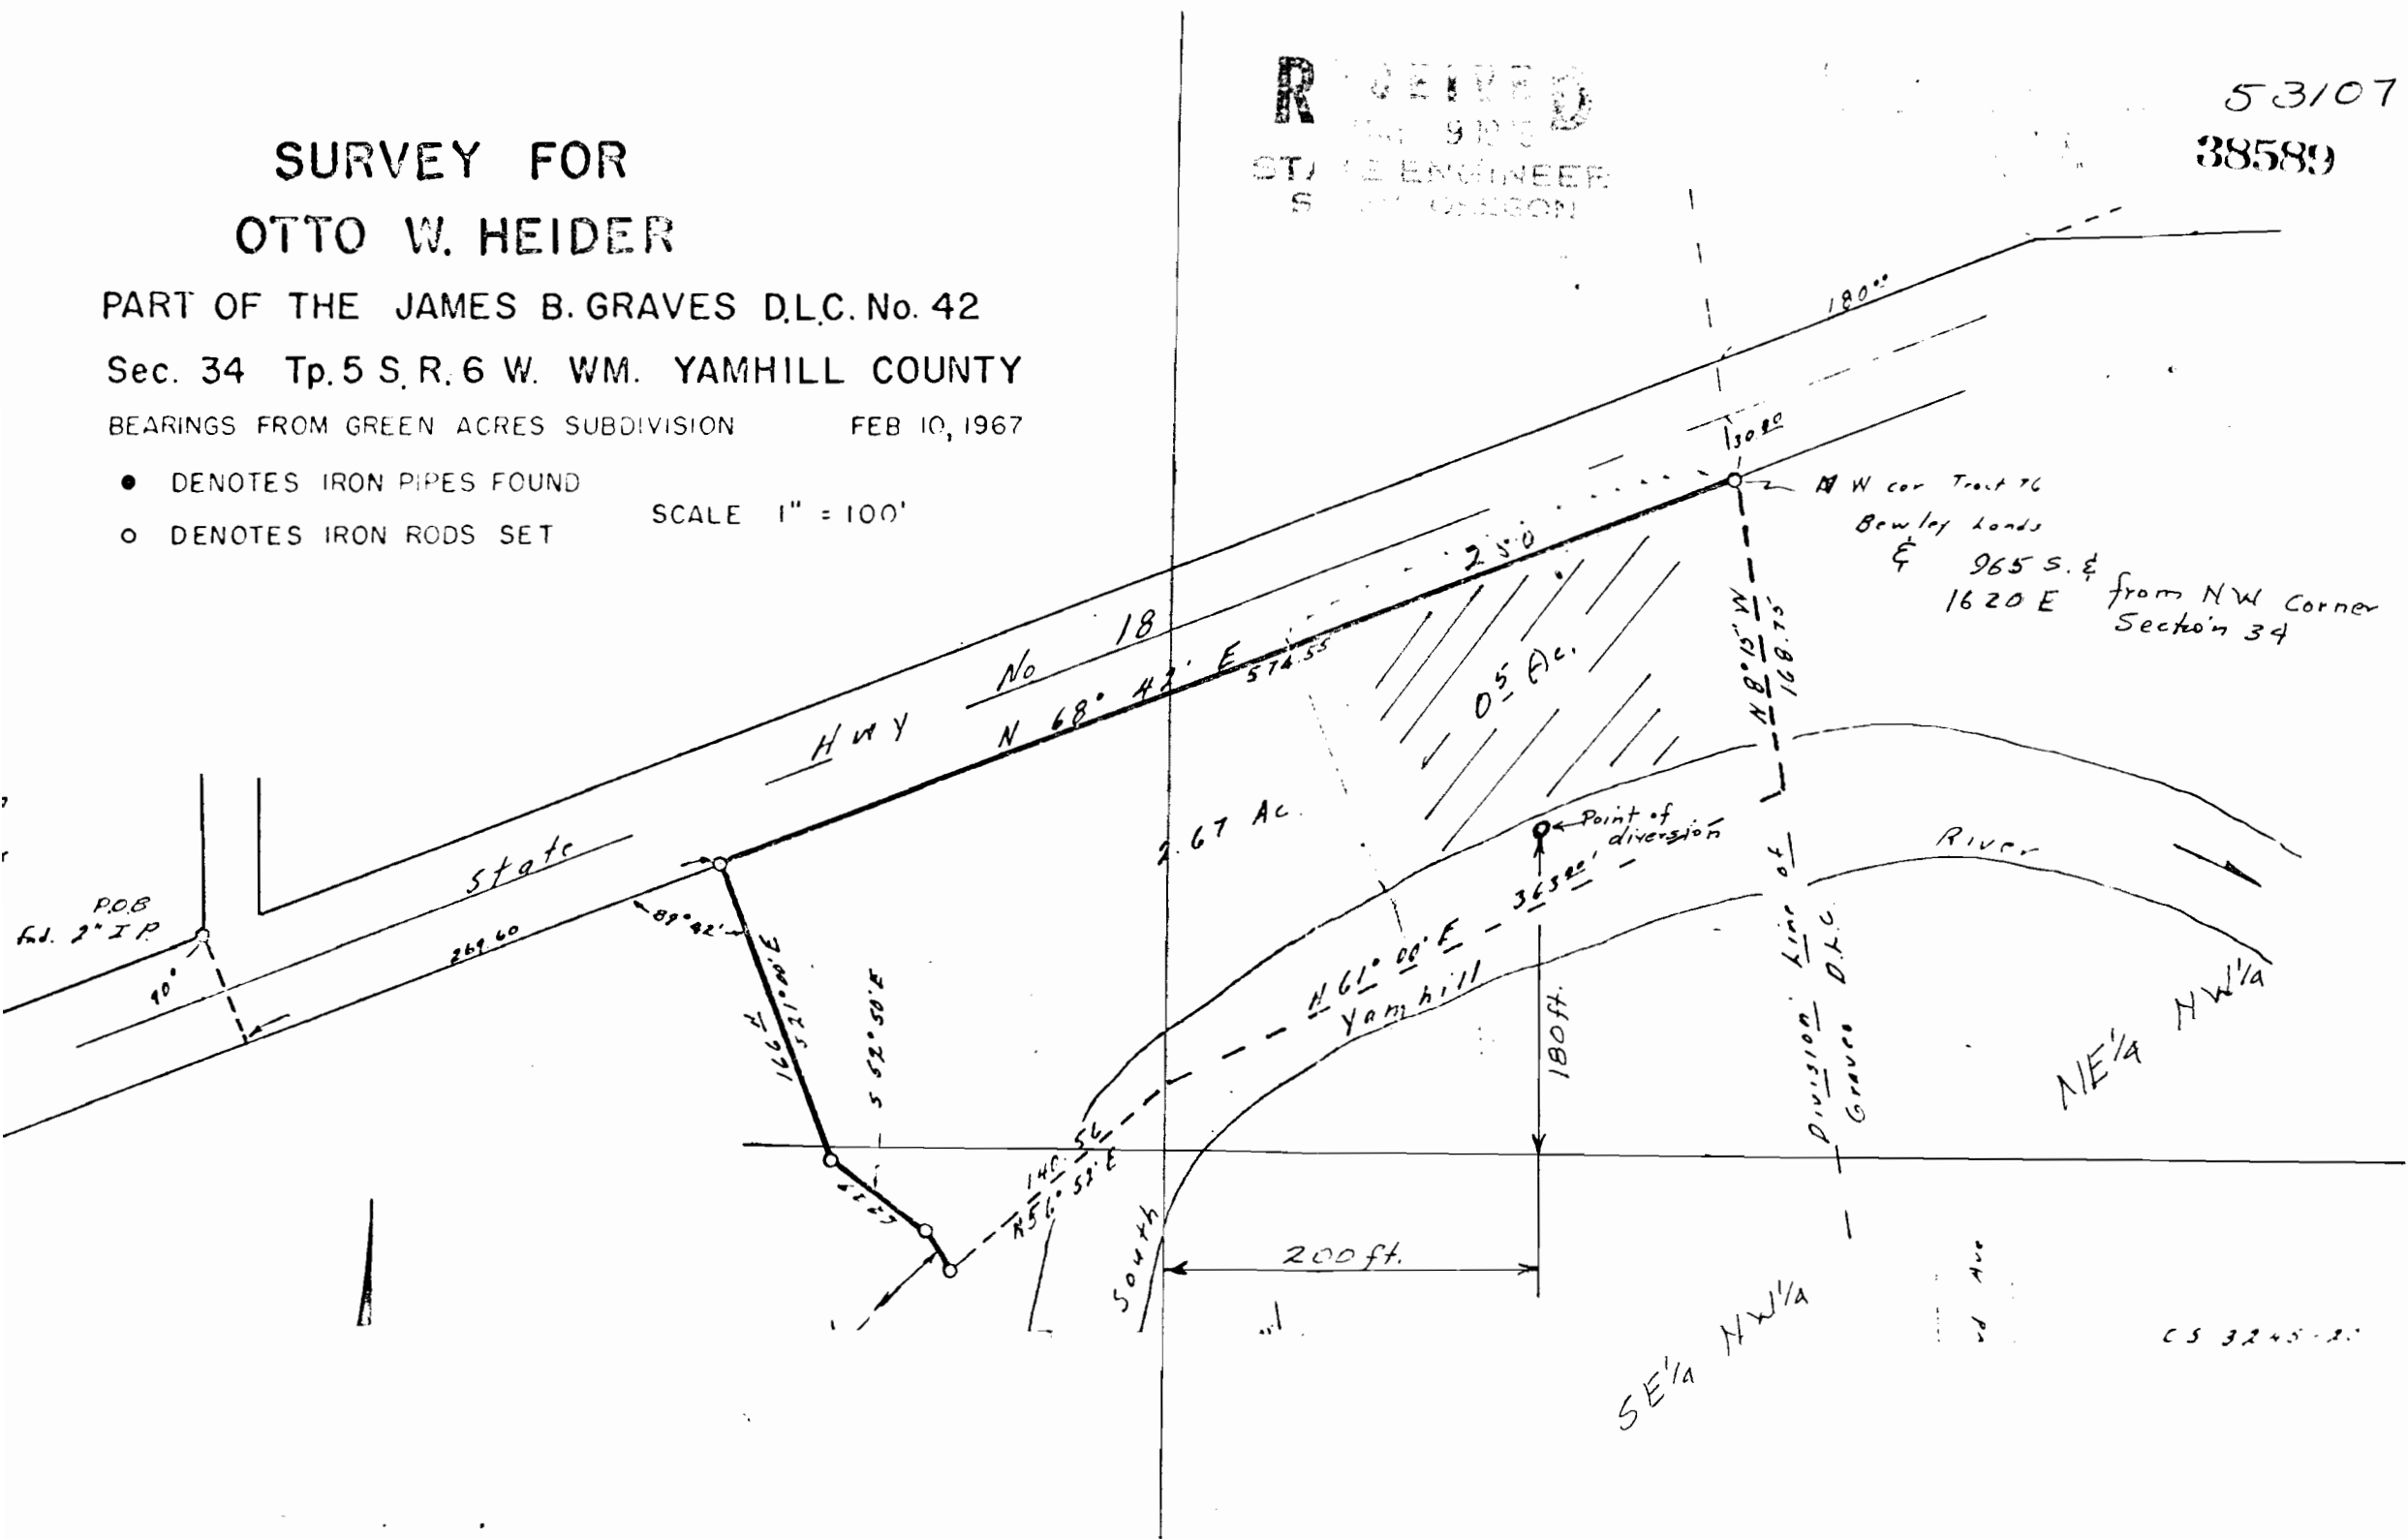

CS 3245-21