

RECEIVED


T. 4 S., R. 5 W., W.M. SEP 23 1999

Location: The SE 1/4, SE 1/4 of Section 5, SW 1/4, NE 1/4, NE 1/4 & the NW 1/4, NE 1/4 of Section 8, T.4 S., R.5 W., W.M., Yamhill County, Oregon.



I certify that the information I have provided in this application is an accurate representation of the proposed water use and is true and correct to the best of my knowledge. This map is to be used for the purpose of identifying the location of water right only and is not intended to provide legal dimensions or locations of property ownership lines.

Matt Dunckel, C.W.R.E.

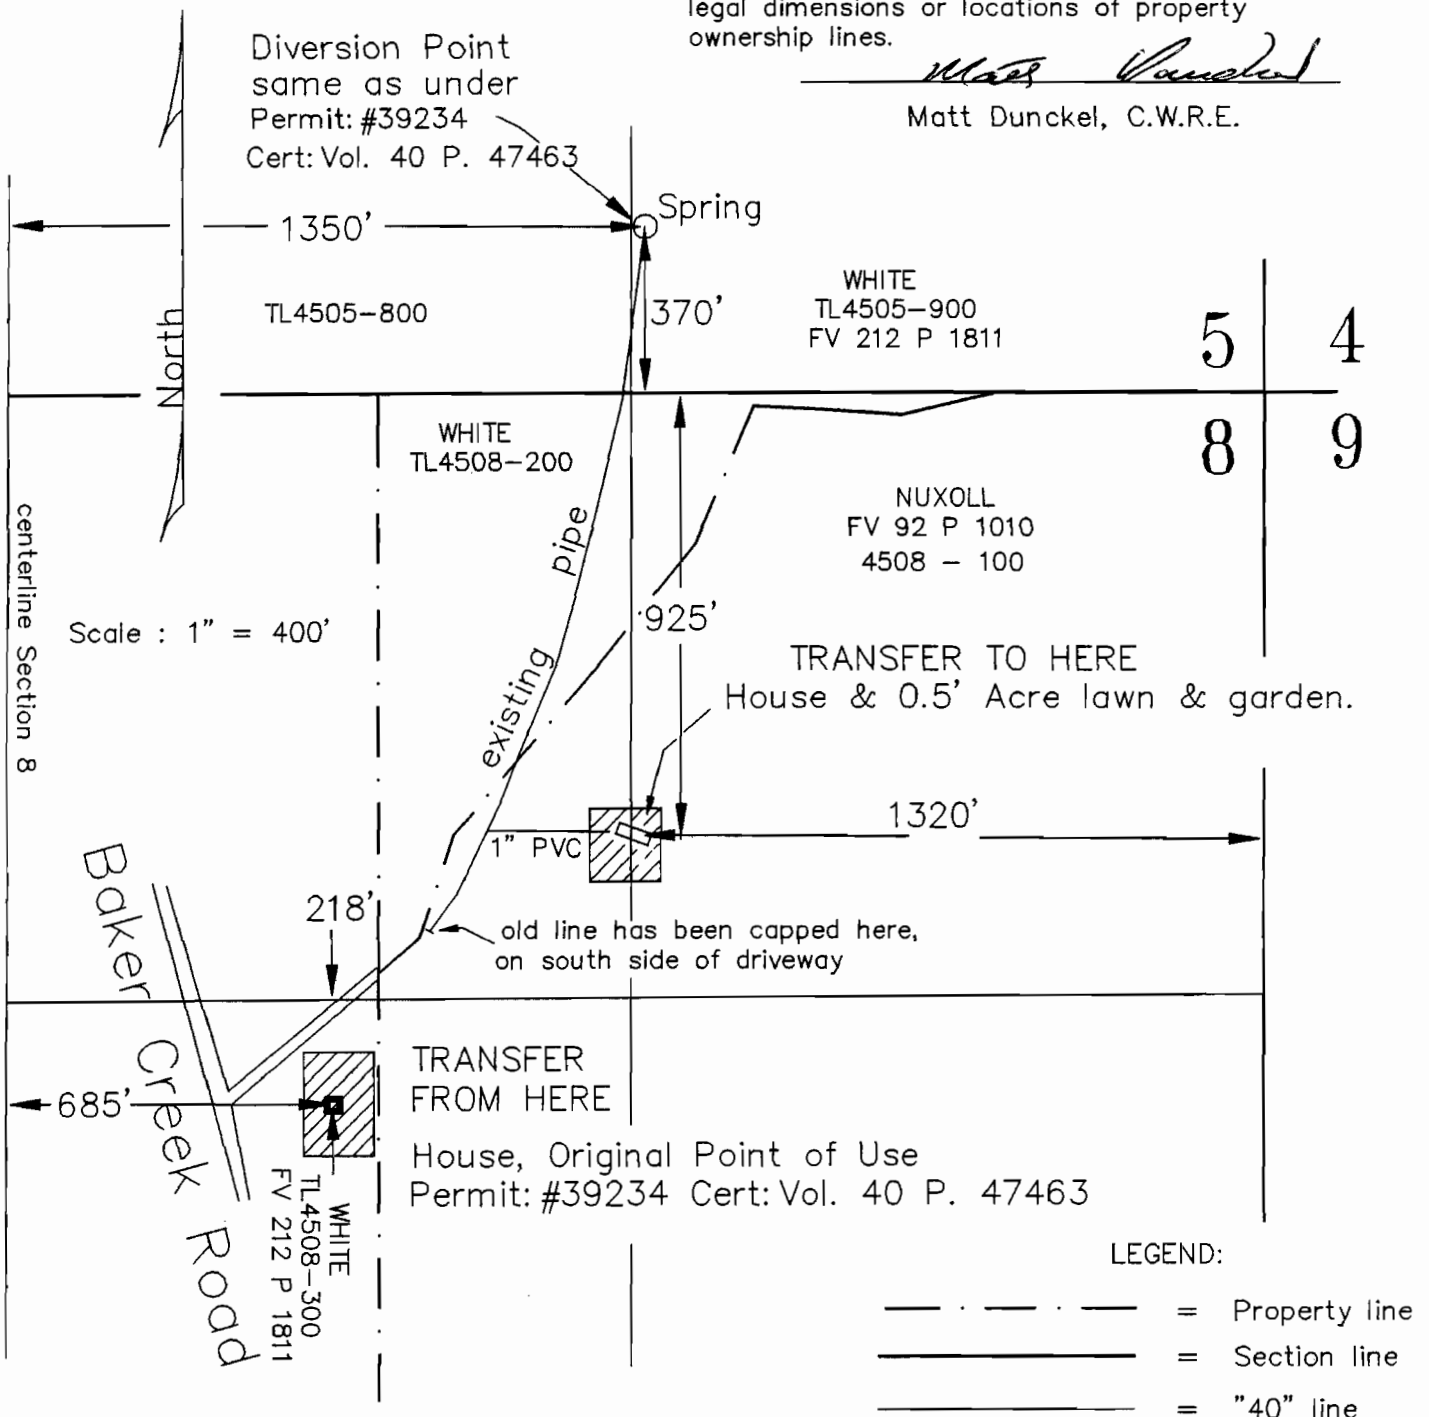

FINAL PROOF SURVEY UNDER

Application No. T-7272 Permit No. 39234 Certificate No. 47463

IN NAME OF

IVAN & DINA NUXOLL

Surveyed Sept. 1 1999