
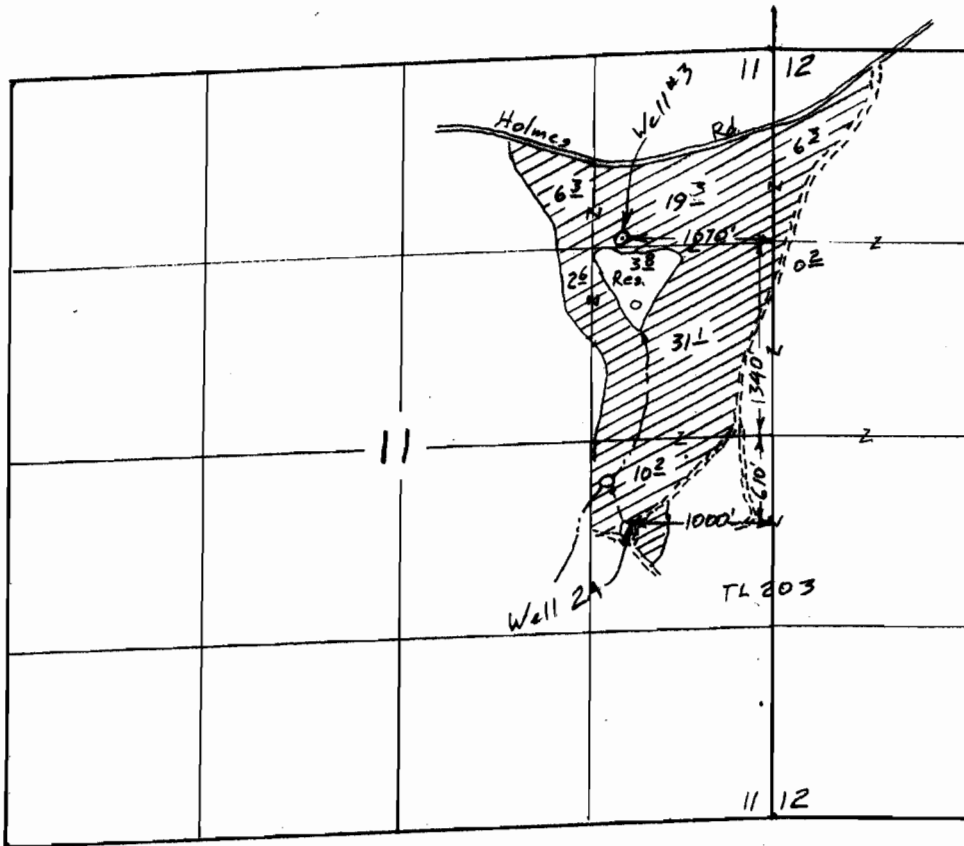


TOWNSHIP 14 SOUTH, RANGE 11 EAST, W.M.

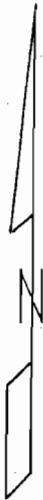

Surveyed Feb 10, 2003 & Oct. 6, 2004

RECEIVED

JUL 25 2005

WATER RESOURCES DEPT
SALEM, OREGON


Claim of Beneficial Use Map
for
STEVEN M. SPARKS REVOCABLE TRUST

App G-13640

Per G-12711

T-9187

& T-9509

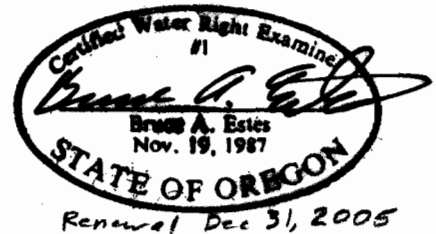

This map is for the purpose of locating a water right only and has no intent to provide legal dimensions or the location of property lines.

ESTES SURVEYS, LLC


PO Box 17519 Salem, OR 97305-7519 (503) 585-7593
60382 Arnold Rd Bend, OR 97702 (541) 382-7301

RECEIVED

FEB 22 2005

WATER RESOURCES DEPT
SALEM, OREGON

TOWNSHIP 14 SOUTH, RANGE 11 EAST, W.M.

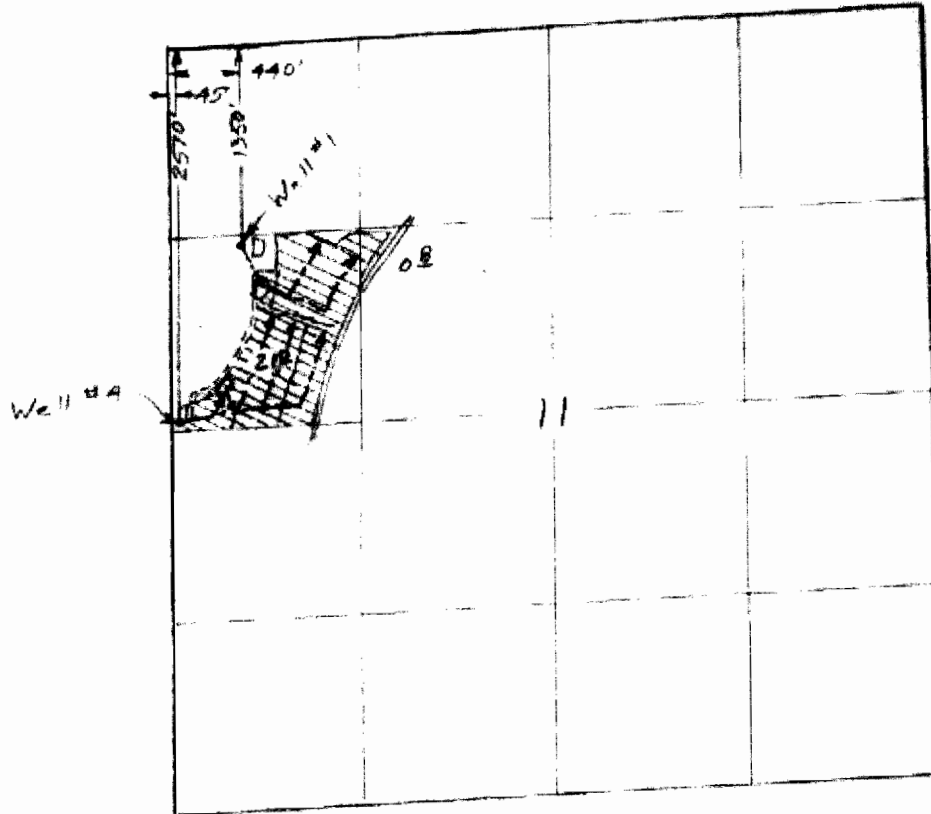


Scale 1" = 1320'

21¹/₂ acres

Surveyed March 24, 2003 & Oct 6, 2004

Claim of Beneficial Use Map
for
STAN STENSTADVOLD

App G- 13640
Permit G- 12711
T- 9187
& T- 9509

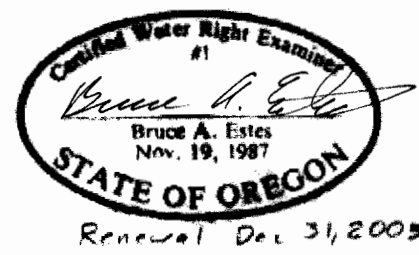

This map is for the purpose of locating a water right only and has no intent to provide legal dimensions or the location of property lines.

ESTES SURVEYS, LLC
 PO Box 17519 60982 Arnold Rd
 Salem, OR 97305-7519 Bend, OR 97702
 (503) 585-7593 (541) 382-7391