


T. 4 N. R. 28 E. W. M.

T-10261

4.7 ac on C38390 - 1.0 ac transferred off = 3.7 ac RR

Remaining Right is C.82991 for 3.7 acres of supplemental irrigation

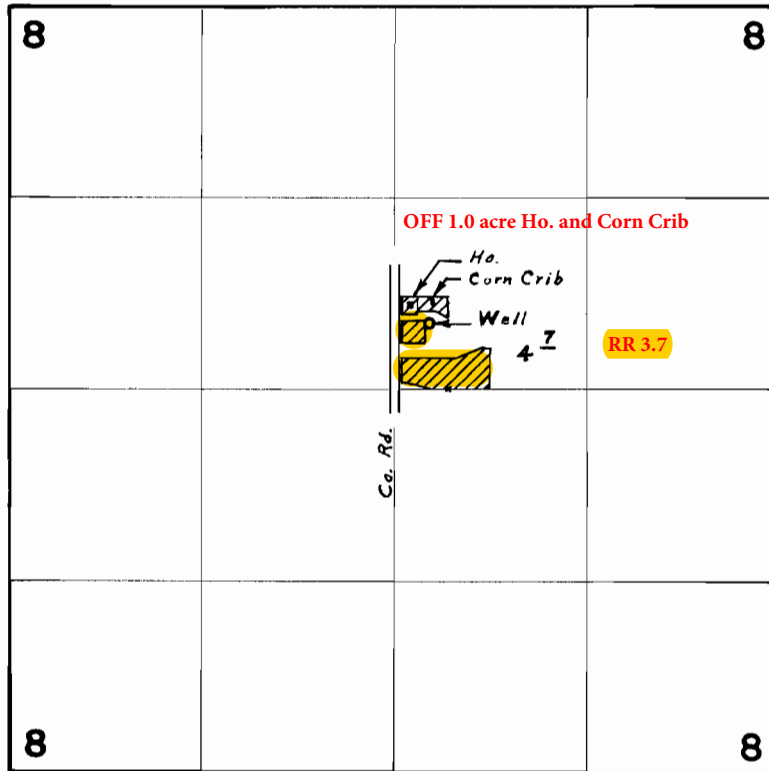

Well located 450' N. & 240' E. From Center Sec. 8

FINAL PROOF SURVEY
UNDER

Application No. G-3991 Permit No. G-3745
IN NAME OF

DAVID C. RALSTON

Surveyed June 22 1971, by L. E. Gould