


T. 7 S., R. 2 W., W.M.

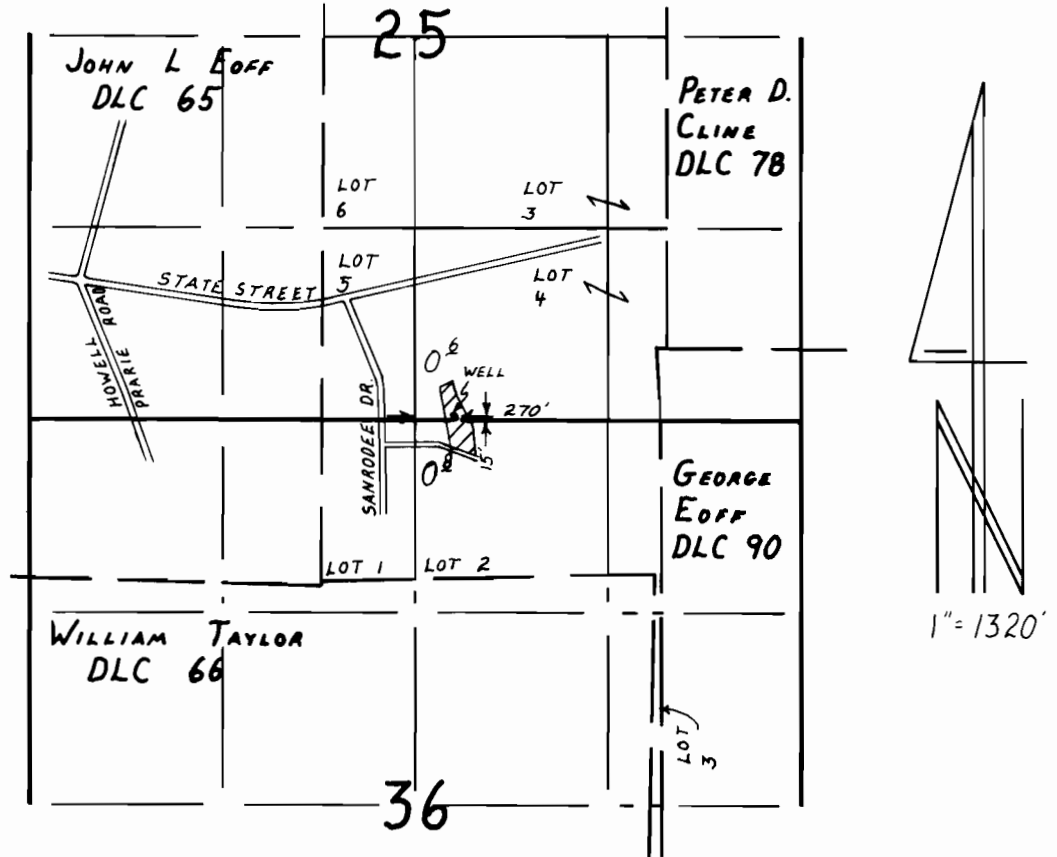

FINAL PROOF SURVEY

UNDER

Application No. G-11624 Permit No. G-10741
IN NAME OF

WALTER W. SCHUTT

Surveyed AUGUST 19, 1992, by R.W. Klassen