
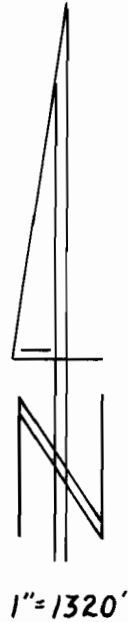


T. 4 S., R. 3 W., W.M.

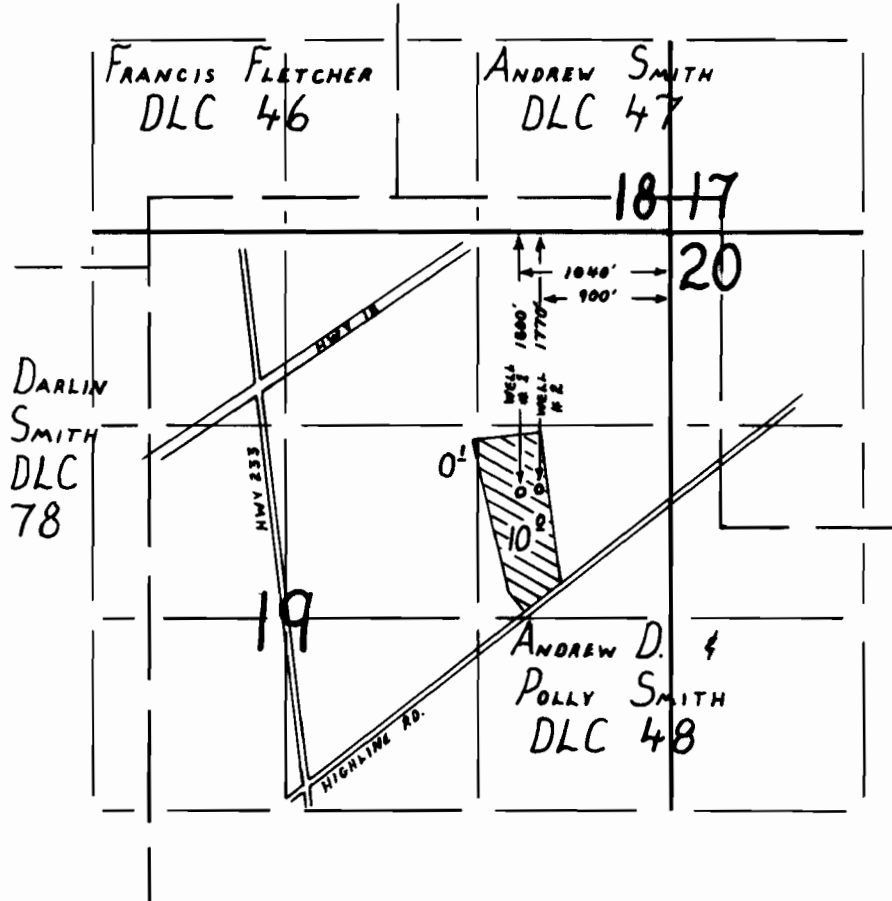

FINAL PROOF SURVEY

UNDER

Application No. G-11585 Permit No. G-10738
IN NAME OF

LOUIS J. SCALVINI

Surveyed FEBRUARY 27, 1991, by R.W. Klassen