


# T. 13 S., R. 29 E., W.M.


**RECEIVED**

JUL - 1 1993

WATER RESOURCES DEPT.  
SALEM, OREGON

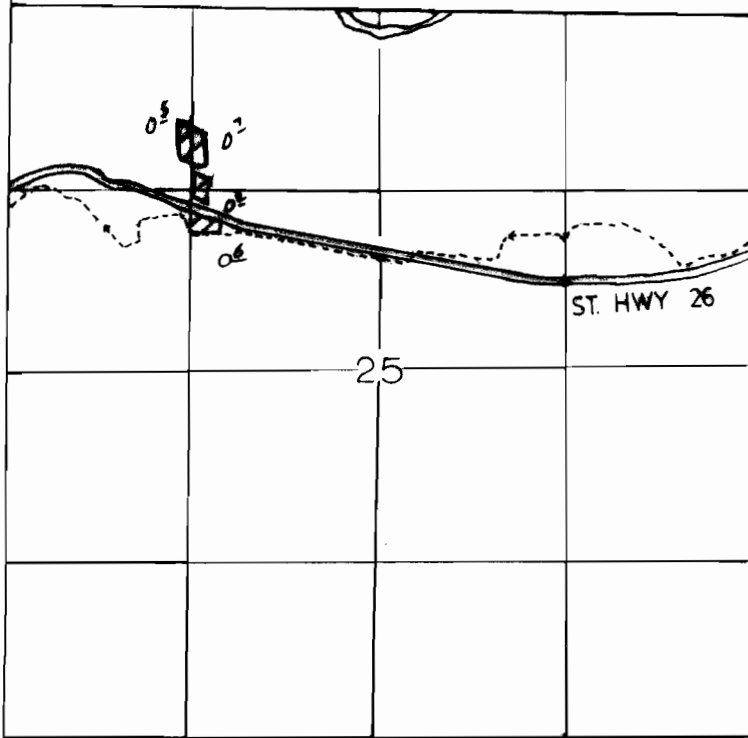

# T. 13 S., R. 30 E.

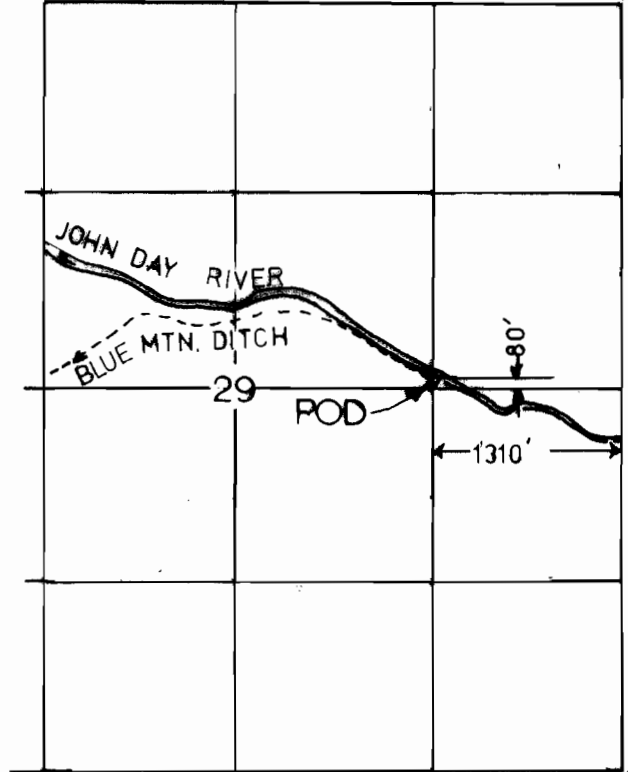

1" = 1320'

## FINAL PROOF SURVEY

UNDER

Transfer No. 5967

IN NAME OF

JOHN A. (JACK) MASSON

Surveyed 1-22, 1991, by K. KEMP

**RECEIVED**

AUG 3 2001

WATER RESOURCES DEPT.  
SALEM, OREGON