


T.8 S., R 25 E., W.M.

RECEIVED

MAY 22 2001

WATER RESOURCES DEPT.  
SALEM, OREGON

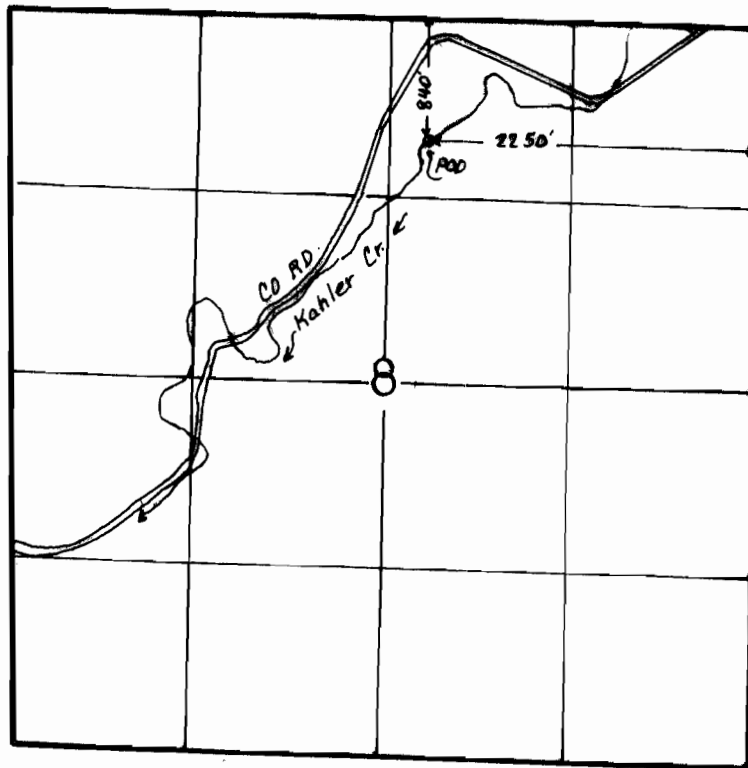

1" = 1320'

**FINAL PROOF SURVEY**  
**UNDER**

TRANSFER NO. 5900

Application No. .... Permit No. ....  
**IN NAME OF**

WILLIAM & MARIE NORGRN

Surveyed 6/15..... 2000, by J.MILLER.....