


T. 35,36 S., R. 9,10 E., W.M.

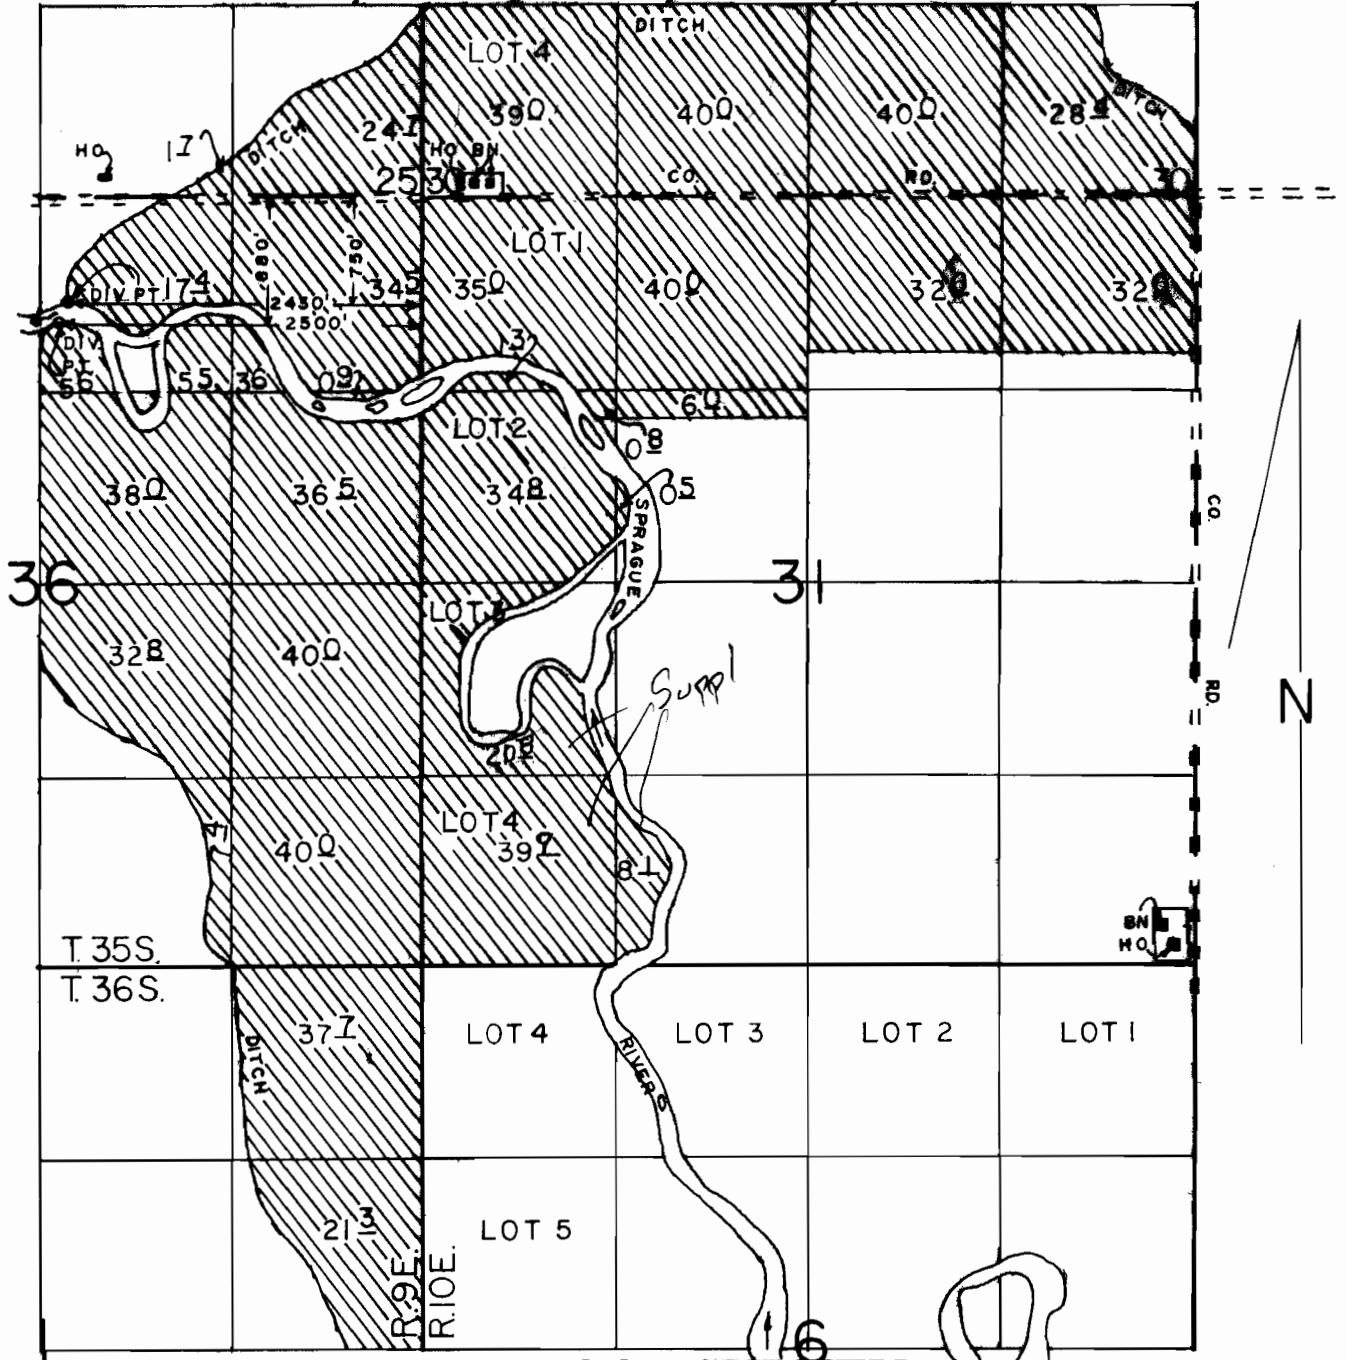

FINAL PROOF SURVEY

UNDER

Application No. 54019 Permit No. 40106
IN NAME OF

CLIFFORD & MARY ANN RABE

Surveyed MAY 11, 1994, by R.M.SUTTERFIELD

SCALE: 1"=1320'