


T. 39 S., R. 8 W., W.M.

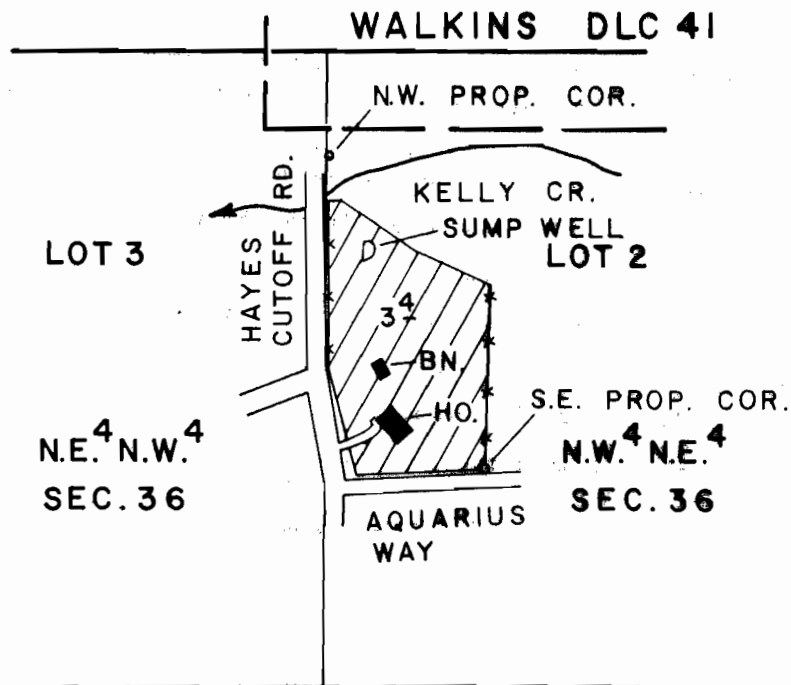

SUMP WELL LOC. - 410 FT. S. & 90 FT. E.
FROM N. 1/4 COR., SEC. 36.

SCALE : 1" = 400 FT.

FINAL PROOF SURVEY UNDER

Application No. G-8010 Permit No. G-7446
IN NAME OF

H. DUANE DILLER

Surveyed JUN. 14 1979, by B. SUND

D.H.M.

P.T.S. - 1979-14 - B