


T. 39S., R. 8 W., W.M.

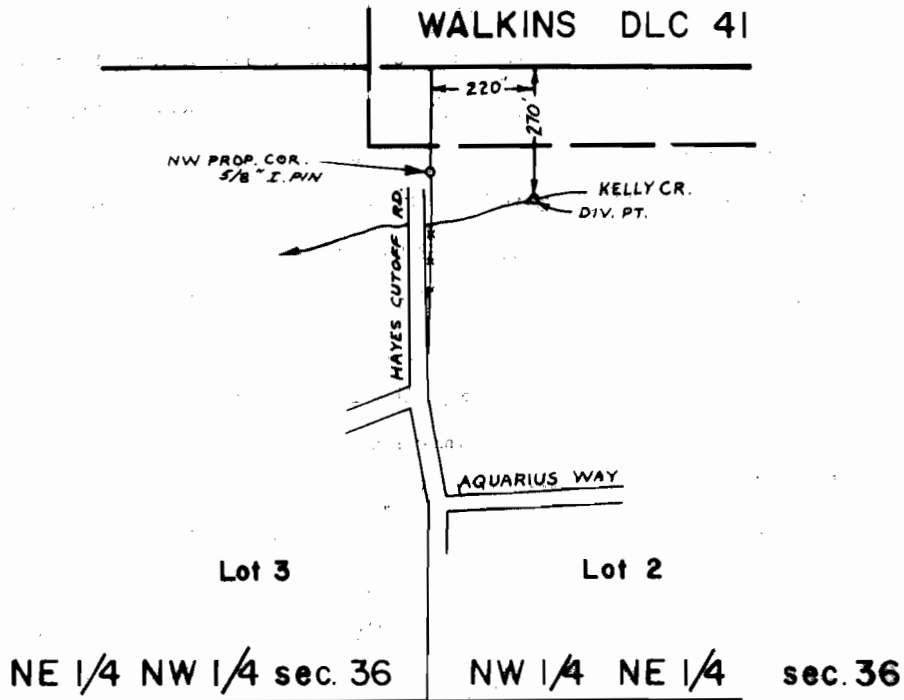

Scale 1" = 400'

**FINAL PROOF SURVEY**  
UNDER

Application No. **55650**.. Permit No. **41551**.....

IN NAME OF

.....**DJANE H. DILLER**.....

Surveyed **April 28, 1980**., by **B.R. SUND**.....