



# T. 11 & 12 S., R. 21 E., W.M.

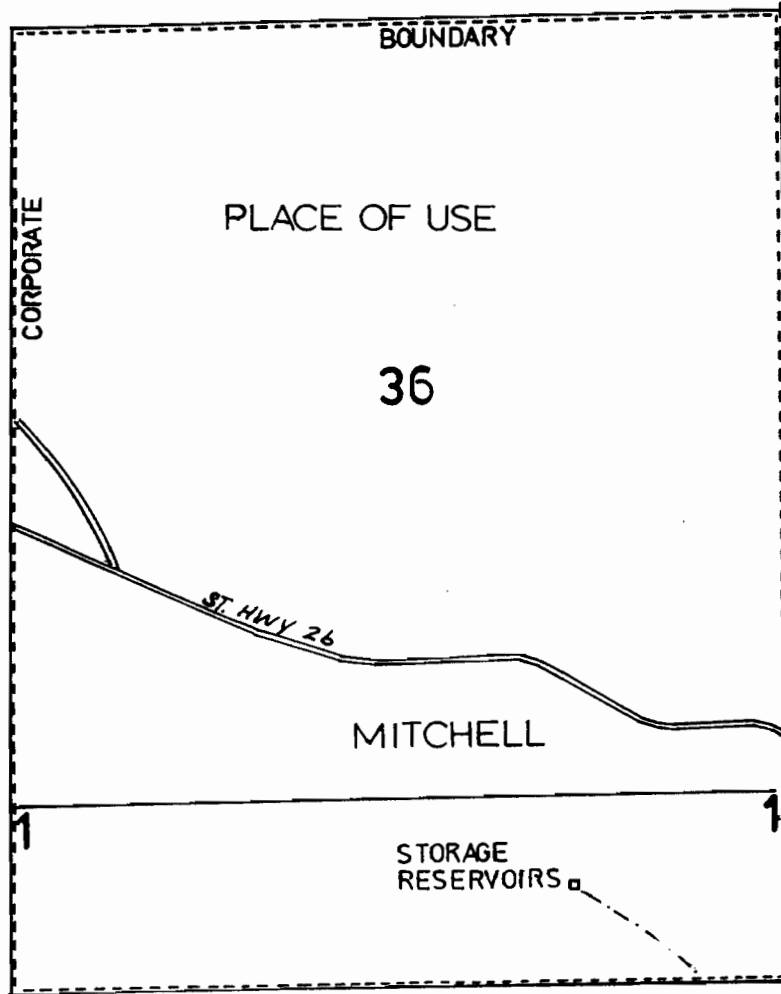

1" = 1320'



## DIVERSION

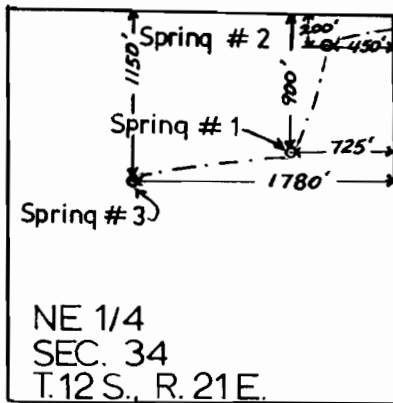

## FINAL PROOF SURVEY

UNDER

Application No. 68293    Permit No. 49356  
68488                      49458  
69150                      50081

IN NAME OF

CITY OF MITCHELL

Surveyed 4-23, 1992, by J. MILLER