

LEGEND

LINE TYPES

- TAX LOT BOUNDARIES:
- OLD PROPERTY LINES:
- RIVERS, LAKES, ETC.:
- CREEKS, POND, ETC.:
- RAILROADS:
- TAX CODE BOUNDARIES:
- SUBDIVISION BOUNDARIES:

SYMBOL TYPES


- CONTROL POINTS:
- SURVEY MONUMENTS:
- G.L.O. CORNERS (APPROX) (FOUND):
 - SECTION:
 - 1/4 SEC:
 - 1/16 SEC:
 - D.L.C.:
- OREGON STATE PLANE COORDINATE SYSTEM GRID MARKS - NAD 27:

NUMBERS

TAX CODE NO.
000 00 00 0

ACREAGE - ALL ACREAGES EXCLUDE ANY PORTION THAT MAY LIE WITHIN THE INDICATED PUBLIC RIGHT OF WAYS.


TICK MARKS - WHEN A TICK MARK IS INDICATED ON THE EXTENSION OF A LINE, THEN THE DIMENSION GOES TO THE TICK MARK, GENERALLY THIS IS USED WHEN DIMENSIONS GO INTO PUBLIC RIGHT OF WAYS.

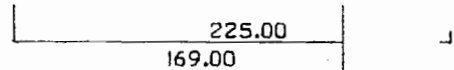

ARROWS ARE USED WITH DIMENSIONS IN AREAS OF GREATER COMPLEXITY.

WARNING: This map was created by digitizing assorted existing maps. NO Research was done. Created for Assessor's Office use ONLY.

STI Informap II Version 3.0

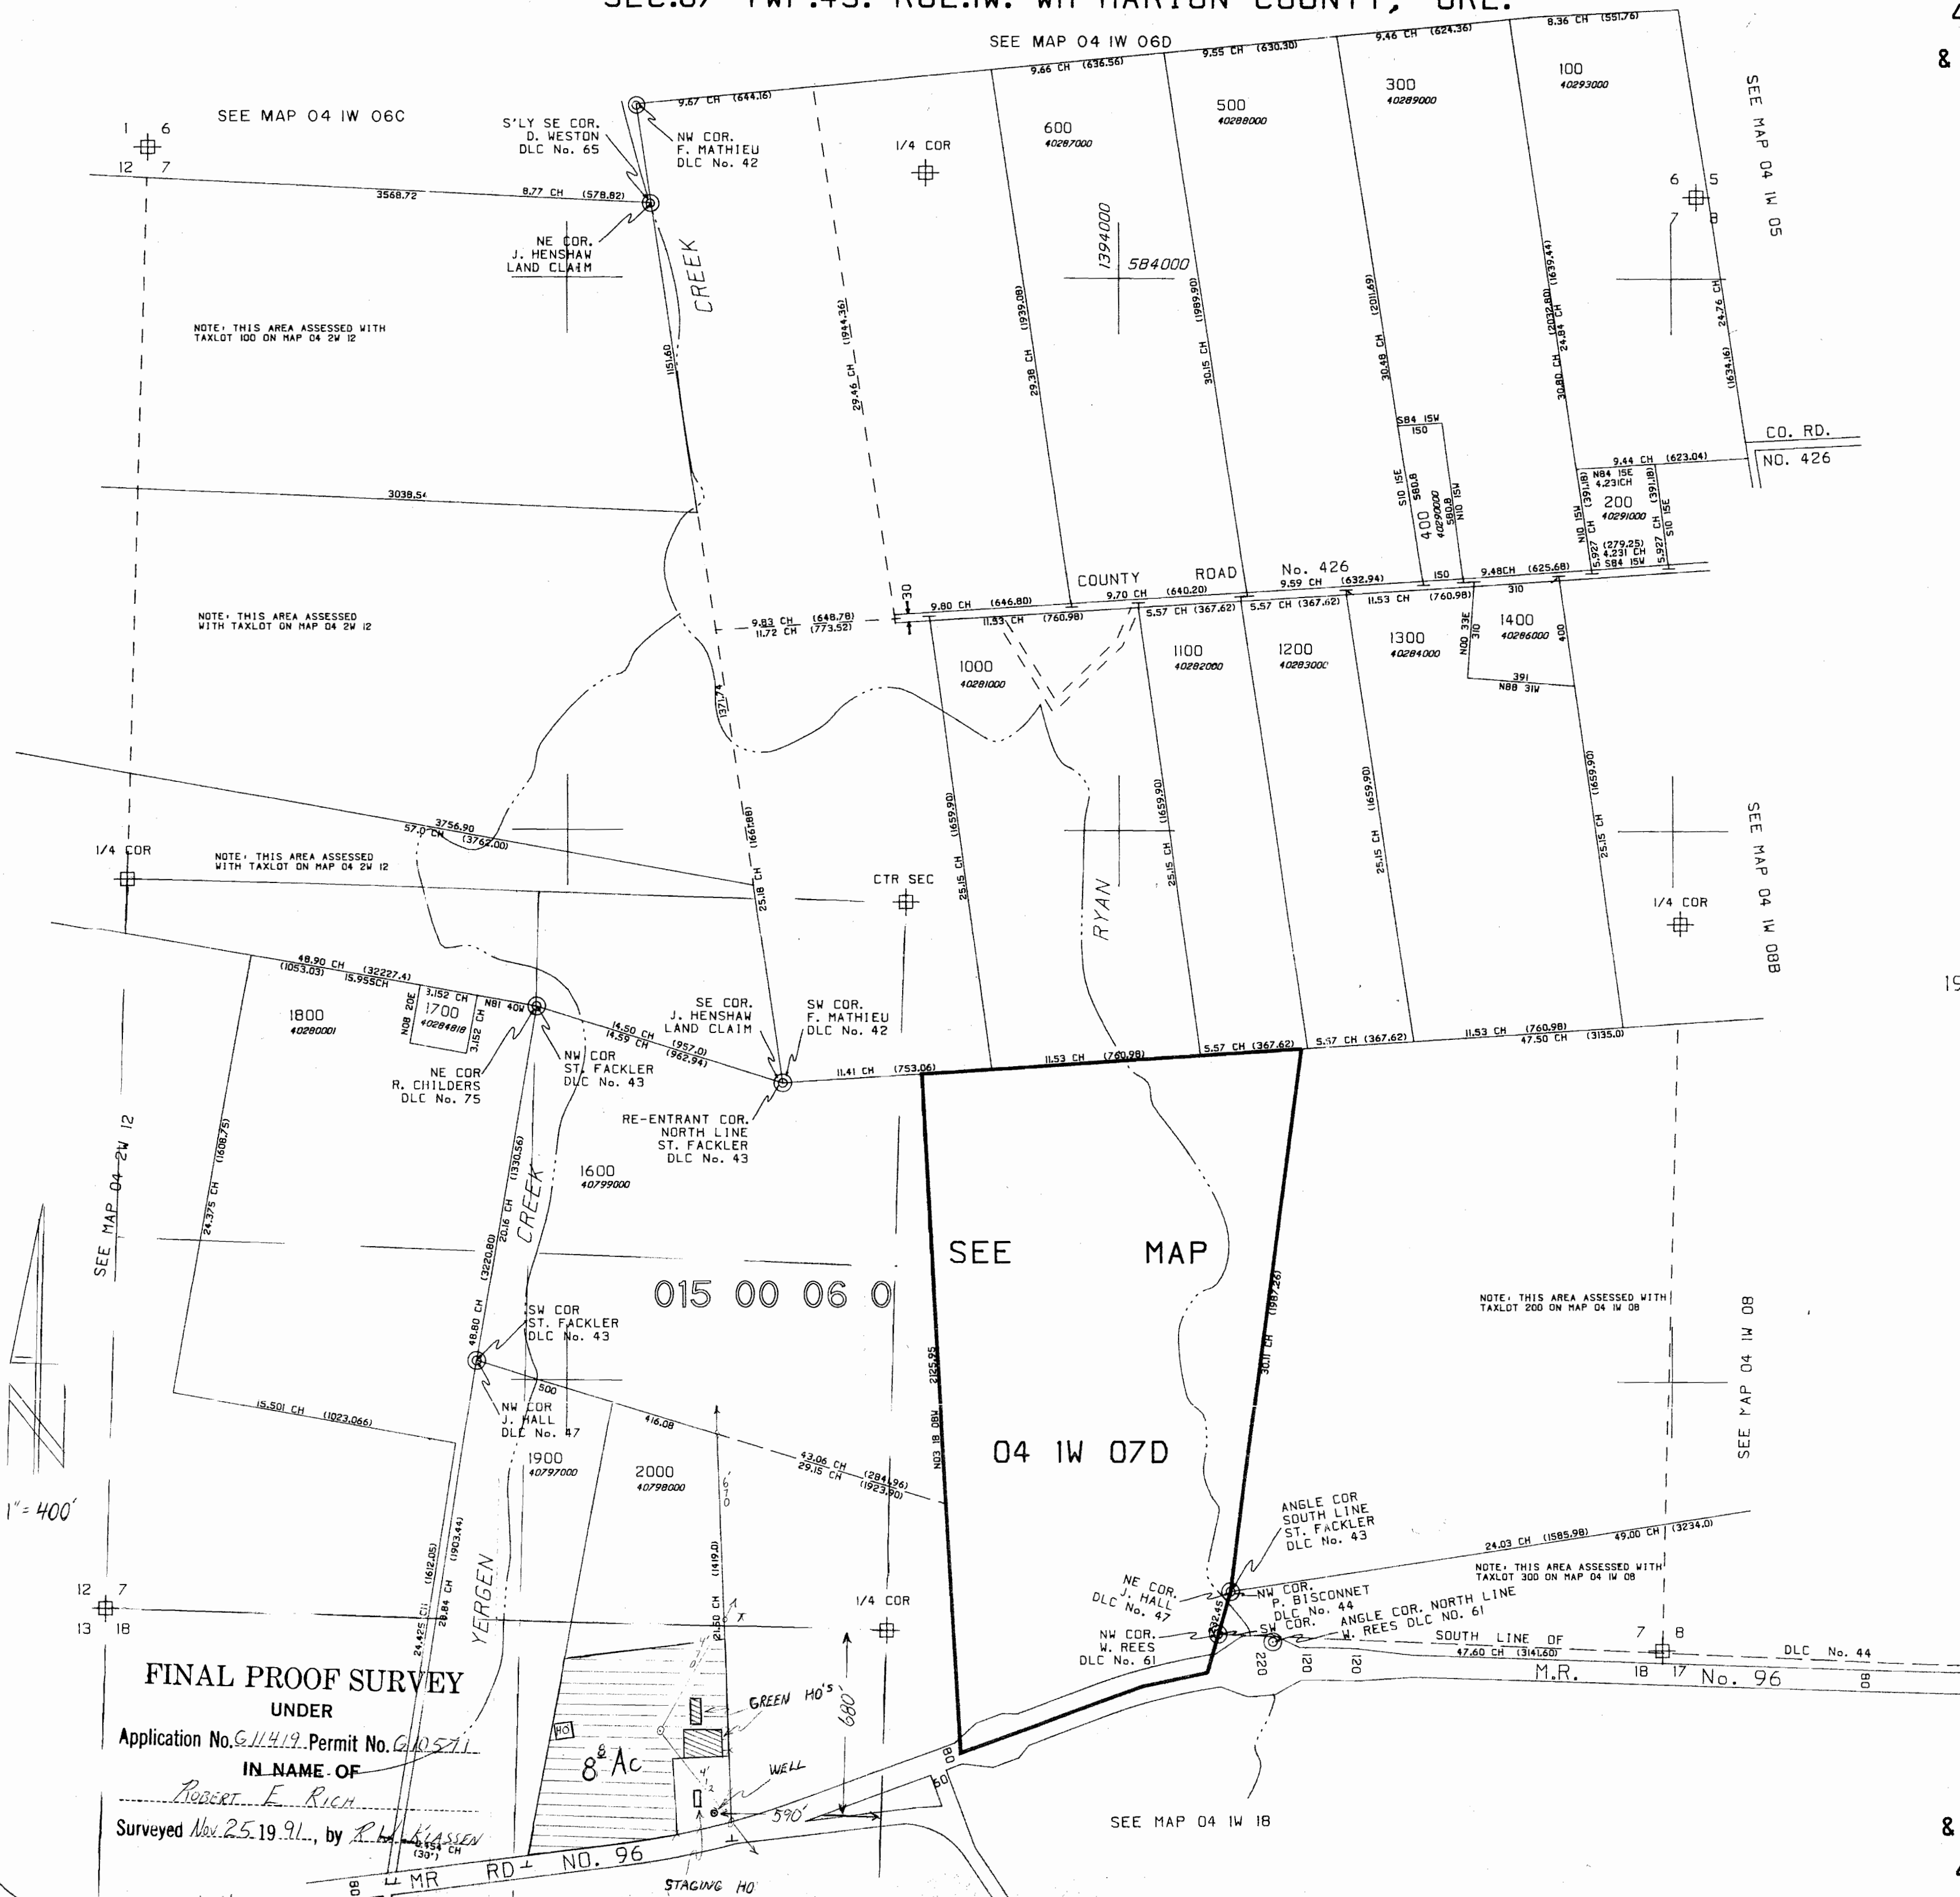

NOTE: THIS AREA ASSESSED WITH TAXLOT 100 ON MAP 04 2W 12

NOTE: THIS AREA ASSESSED WITH TAXLOT ON MAP 04 2W 12

NOTE: THIS AREA ASSESSED WITH TAXLOT ON MAP 04 2W 12

NOTE: THIS AREA ASSESSED WITH TAXLOT 200 ON MAP 04 1W 08

NOTE: THIS AREA ASSESSED WITH TAXLOT 300 ON MAP 04 1W 08

FINAL PROOF SURVEY UNDER


IN NAME OF

Robert E. Rich

Surveyed *Nov. 25, 1991*, by *R.L. Kasen*

1" = 400'
19-FEB-88