


T. 36 S., R. 24 E., W.M.

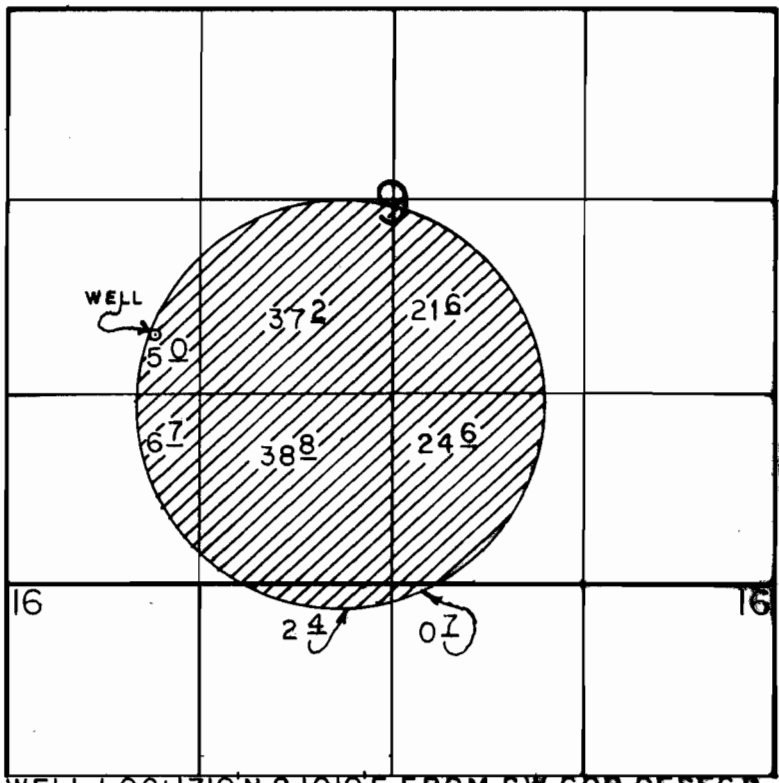

WELL LOC: 1710' N & 1010' E FROM SW COR. OF SEC 9.

SCALE 1" = 1320'

FEB - 8 1994

WATER RESOURCES DEPT.
SALEM, OREGON

FINAL PROOF SURVEY UNDER

Application No. G-9517. Permit No. G-8914...
IN NAME OF

...FITZGERALD...RANCH.....

Surveyed AUG. 24, 1990, by B.W. BISHOP....