


T.39 S., R.19 E., W.M.

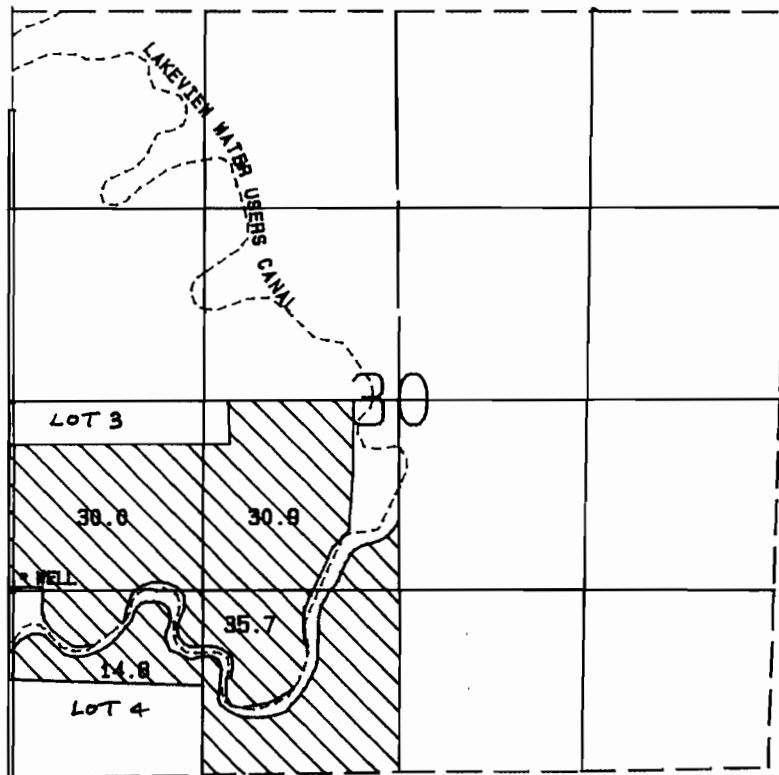

WELL LOCATED 1380 FT. N. AND 80 FT. E. FROM SW COR. SEC. 30

SCALE: 1 = 1320

FINAL PROOF SURVEY
UNDER

Application No. G-9360 Permit No. G-8775

IN NAME OF

CARL R & RITA M. McBRIDE
Surveyed OCT. 17, 1987 BY T.W. WARREN

Photo: 41037-379-82R RMK/LN