


T. 35 S., R. 24 E., W.M.

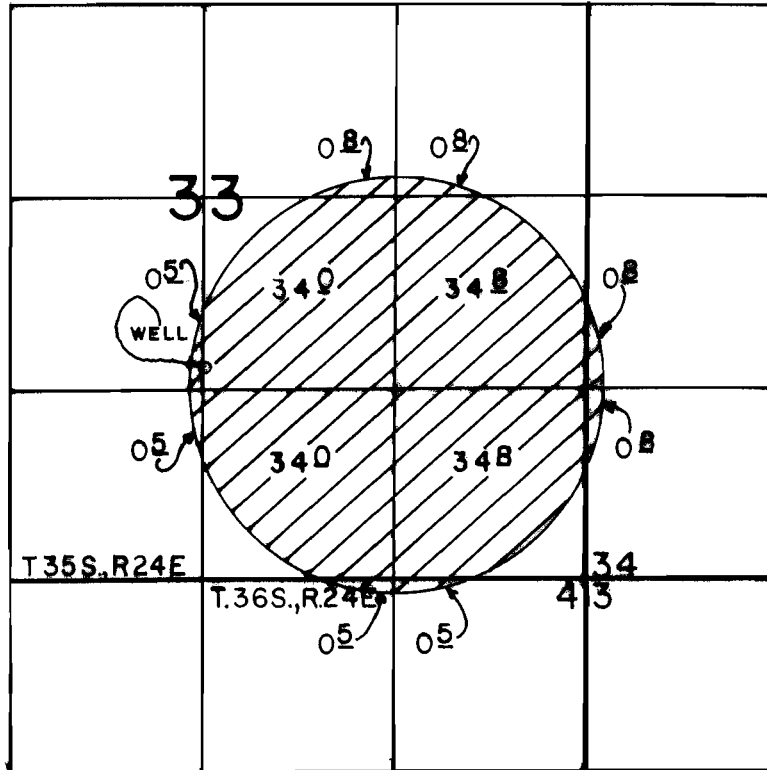

WELL LOC: 1450' N & 2620' E FROM SE COR. OF SEC 33.

SCALE: 1" = 1320'

FEB - 8 1994

WATER RESOURCES DEPT
SALEM, OREGON

FINAL PROOF SURVEY

UNDER

Application No. G-8722 Permit No. G-8098
IN NAME OF

FLYNN BROTHERS

Surveyed AUG 24, 1994, by B.W.BISHOP