




T. 38 & 39S., R. 11 1/2 E., W.M.

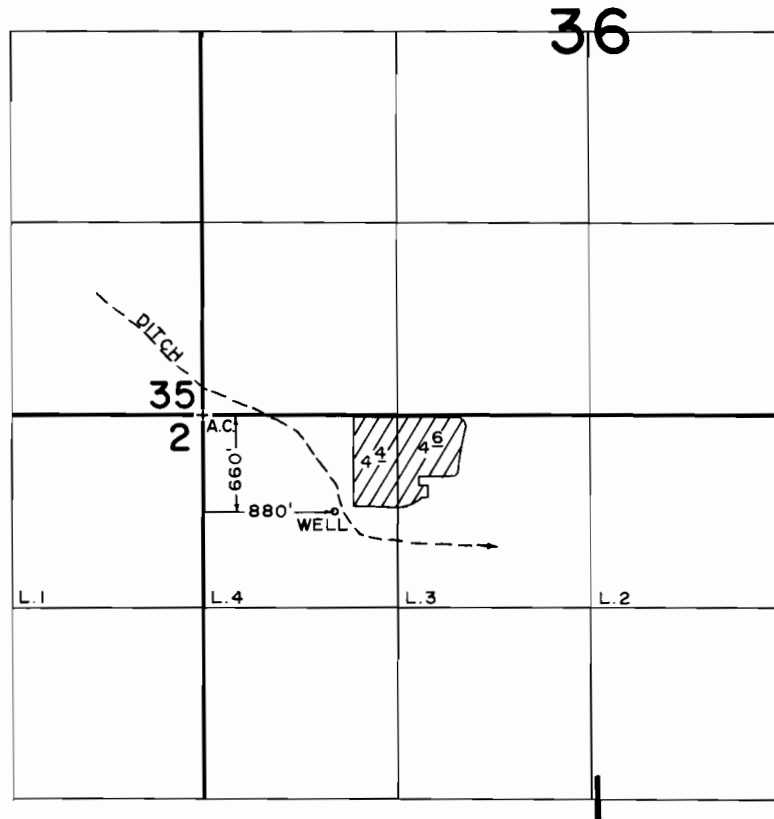

SCALE: 1" = 1320'

**FINAL PROOF SURVEY**  
UNDER

Application No. G-11353 Permit No. G-10476  
IN NAME OF

JAMES W. & ALENE R. JAY

Surveyed SEPT. 18, 1989, by B. W. BISHOP