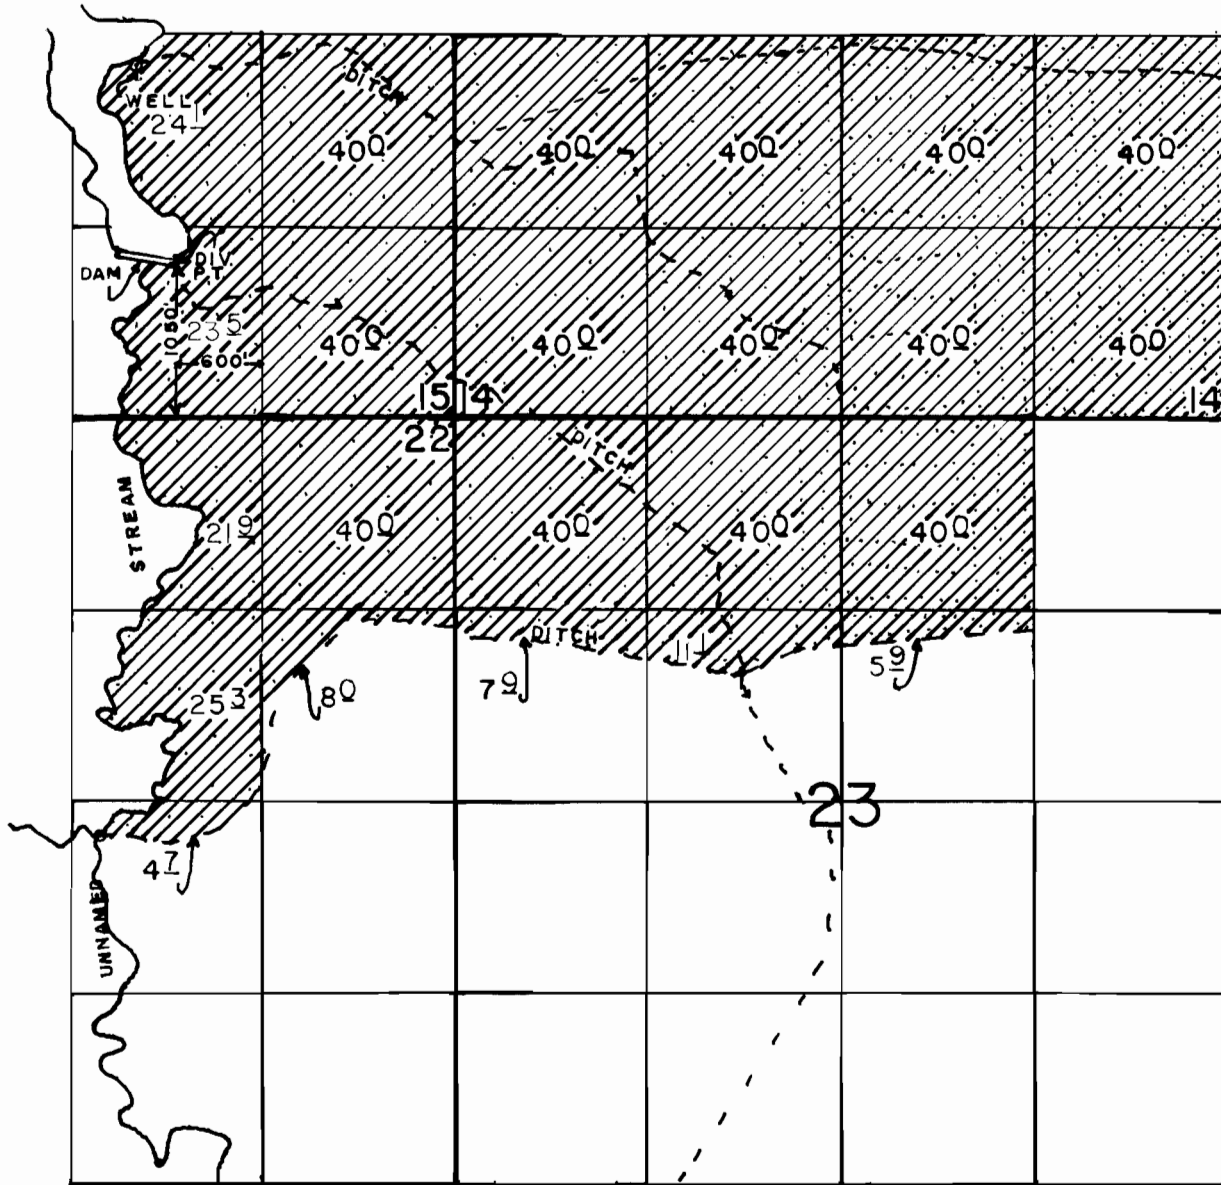


T.30S., R.8E., W.M.


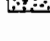


WELL LOC: 2430' N & 2180' W FROM SE COR. OF SEC 15.

SCALE: 1" = 1320'

FINAL PROOF SURVEY

UNDER

Application No. G-6197 53248 Permit No. G-5233 39515  PRIMARY
 IN NAME OF  SUPPLEMENTAL

MATHIS TRUST C/O GLENN E. MATHIS

Surveyed JUNE 21, 1994, by R.M.SUTTERFIELD