T.30S., R.8E., W.M.

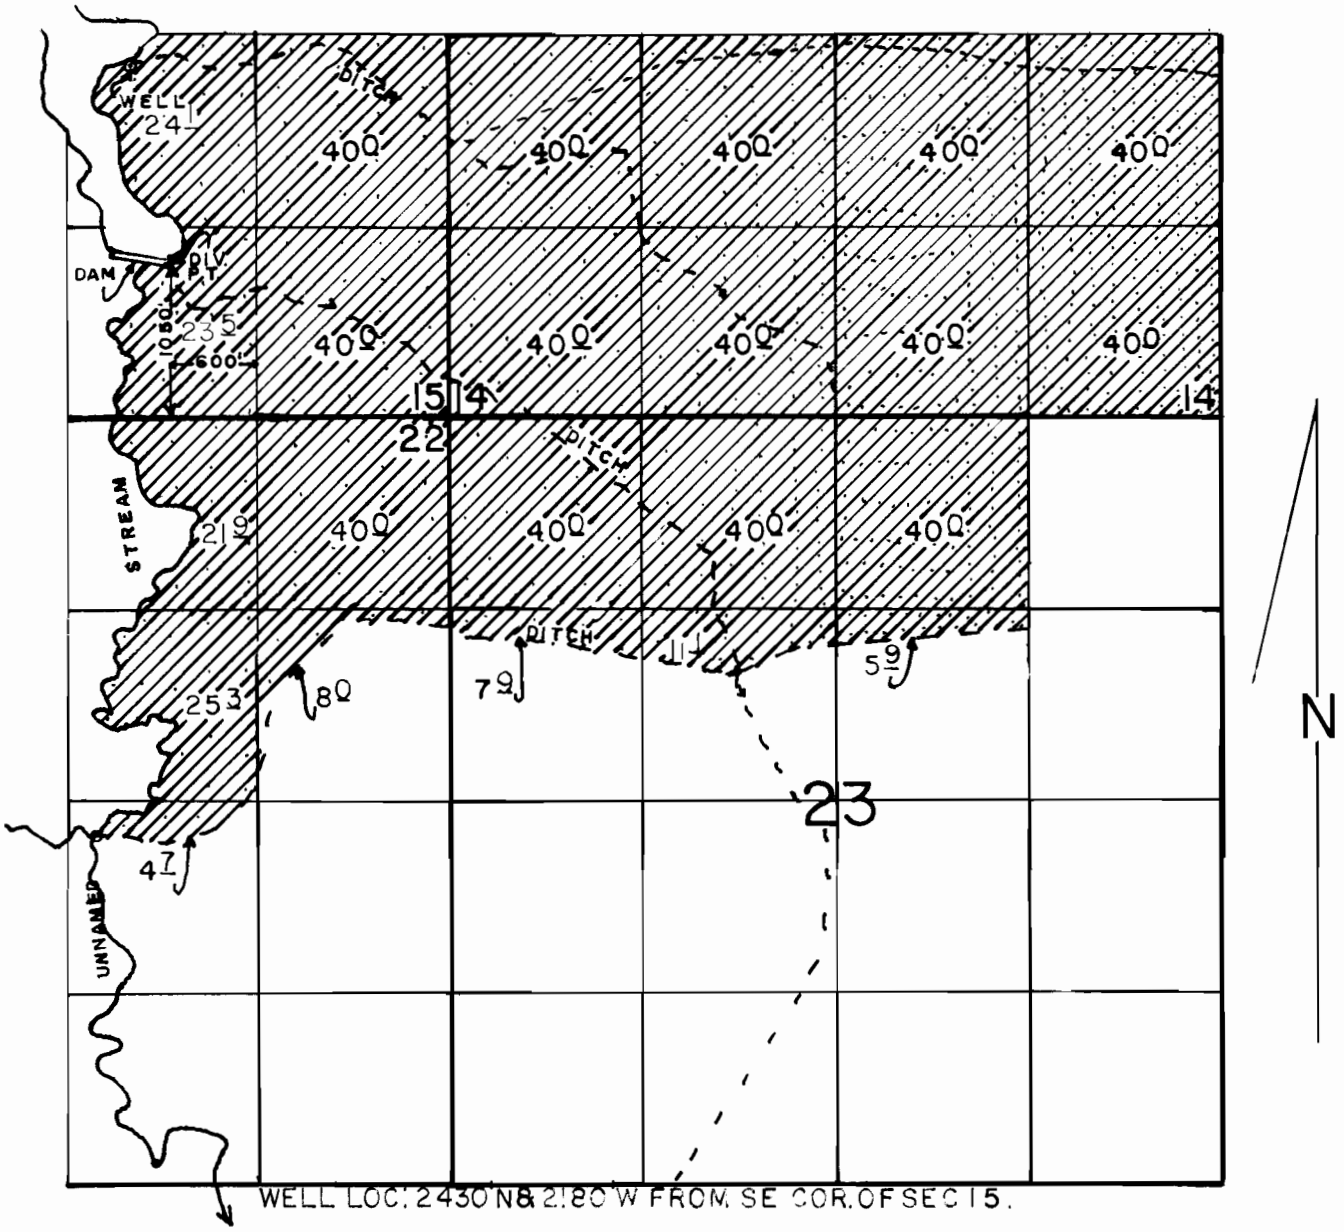

WELL LOC: 2430'N & 2180'W FROM SE COR. OF SEC 15.

SCALE: 1" = 1320'

FINAL PROOF SURVEY

UNDER

Application No. G-6197 53248 Permit No. G-5233 39515 ▨ PRIMARY ▩ SUPPLEMENTAL

IN NAME OF

MATHIS TRUST C/O GLENN E. MATHIS

Surveyed JUNE 21, 1994, by R.M.SUTTERFIELD

PHOTO 41035-178-32A 10/21/94 R.M.S.