


T.4S., R.12E., W.M.

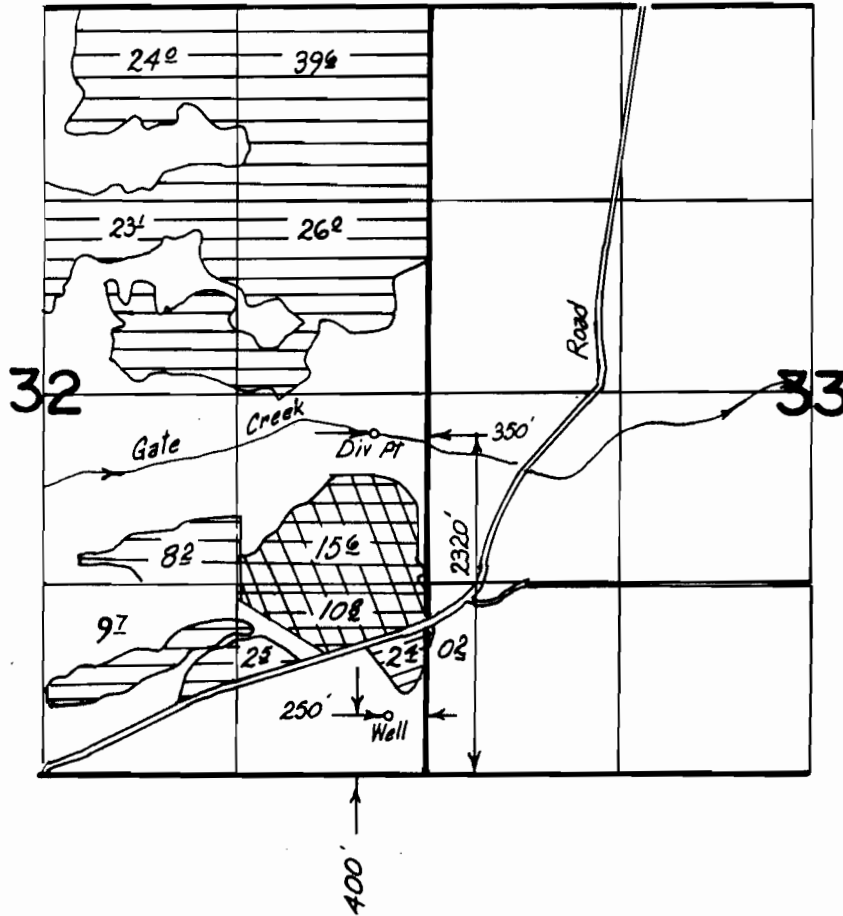




FINAL PROOF SURVEY UNDER

Application No. **G-9577** 58513 Permit No. **G-9254** 46164
IN NAME OF

RICHARD T. BLAINE

Surveyed ...6-21... 1984., by Larry Tall.....

-  Gate Creek
-  Gate Creek, Well (Suppl)
-  Well (Primary)

Scale: 1" = 1320'