


T.4S., R.12E., W.M.

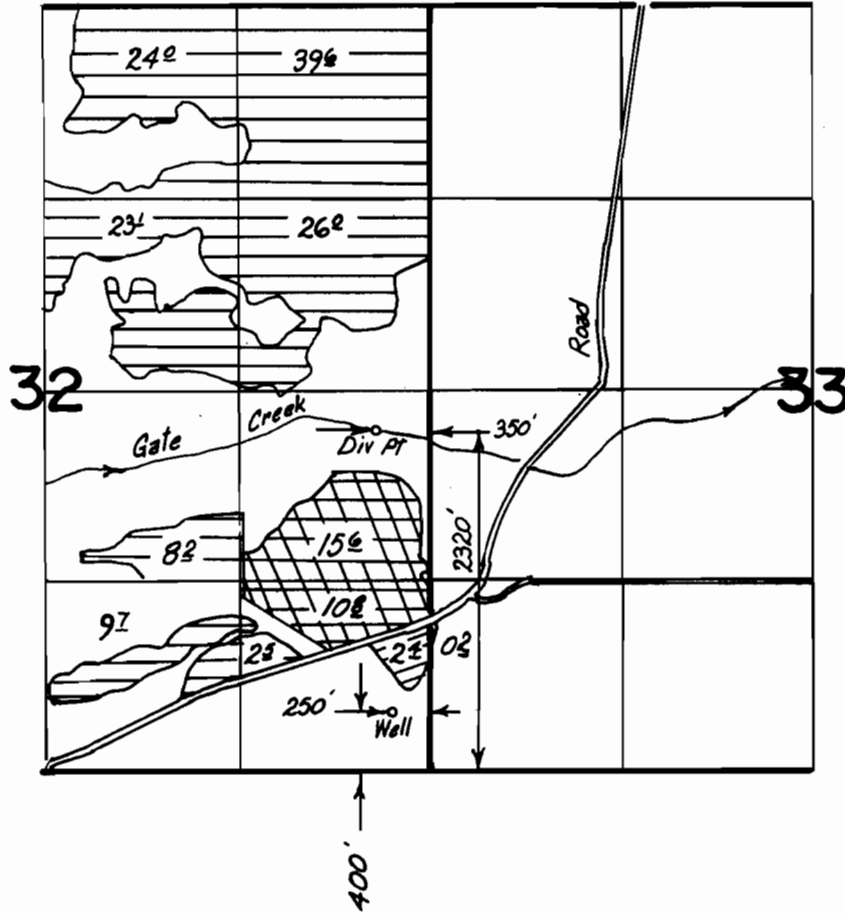

Scale: 1" = 1320'




FINAL PROOF SURVEY

UNDER

Application No. **G-9577** Permit No. **G-9254**
58513 **46164**
 IN NAME OF

RICHARD T. BLAINE

Surveyed ...6-21... 1984... by *Larry Tall*.....

-  Gate Creek
-  Gate Creek, Well (Suppl')
-  Well (Primary)