


T. 3 N., R. 1 W., W.M.

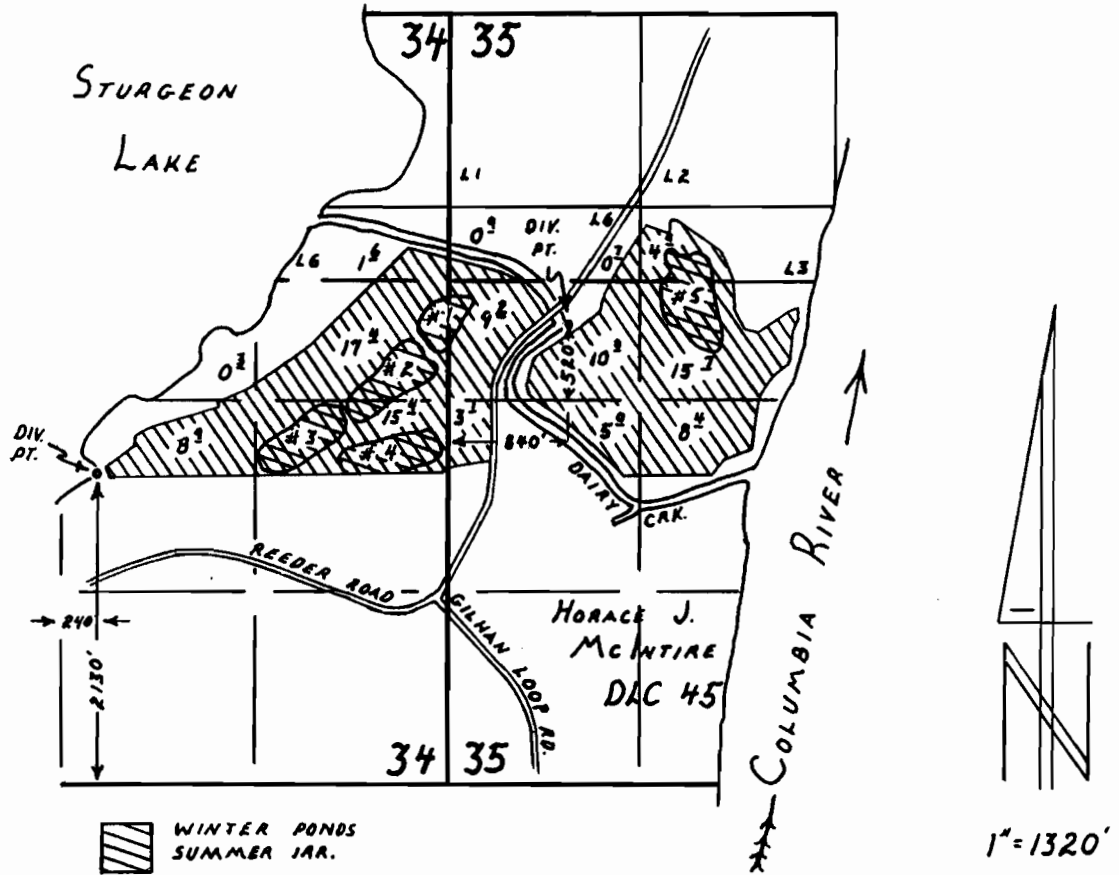

FINAL PROOF SURVEY

UNDER

Application No. R-61321, 61322, R-63439, 63440 Permit No. R-8290, 45909, R-8384, 46578
IN NAME OF

Mike Cereghino

Surveyed September 29, 1993, by R.W. Klassen