
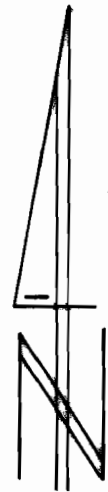


T. 8 S., R. 10 W., W.M.

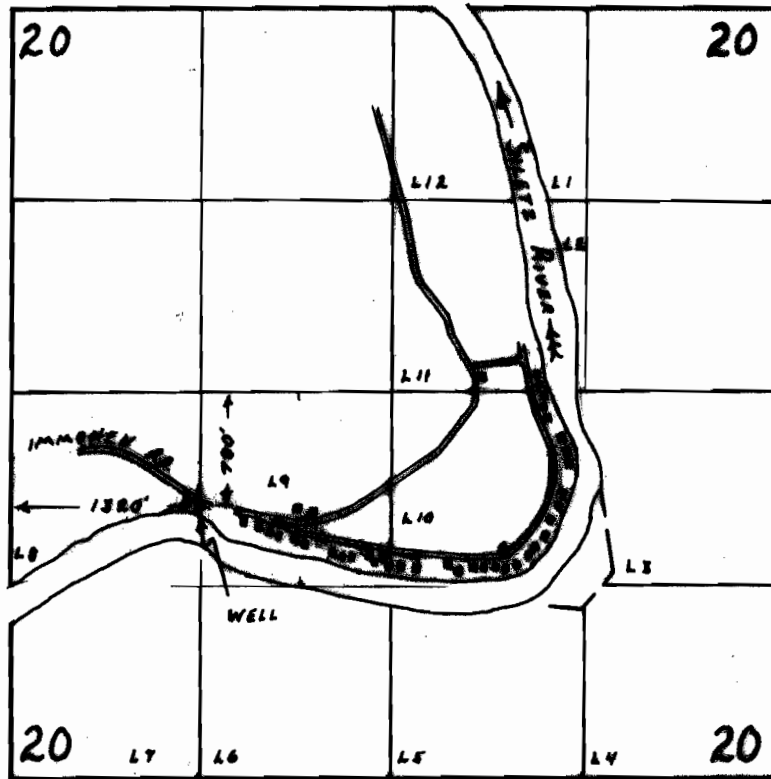

1" = 1320'

FINAL PROOF SURVEY

UNDER

Application No. G-5418 Permit No. G-4842
IN NAME OF

Calkins Acres Improvements, Inc.

Surveyed August 24, 1993, by R.W. Klassen