
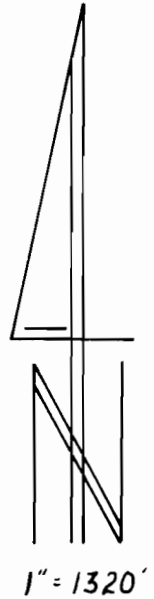


T. 6 S., R. 3 W., W.M.

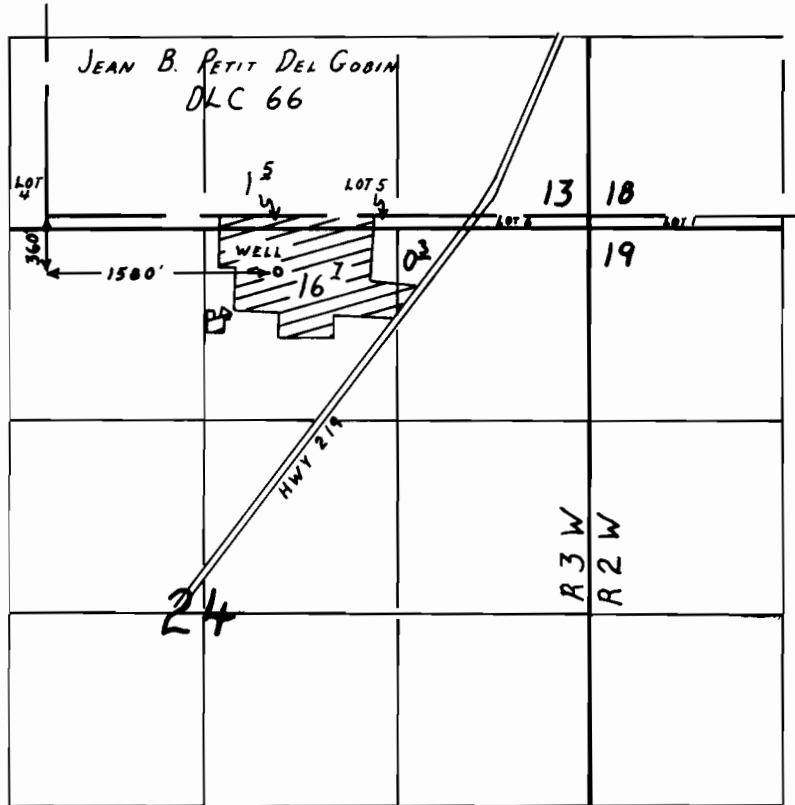

FINAL PROOF SURVEY

UNDER

Application No. G-11611 Permit No. G-10690
IN NAME OF

RONALD G. BOLTMAN

Surveyed MARCH 13, 1991, by R.W. Klassen