


T. 25 S., R. 23 E., W.M.

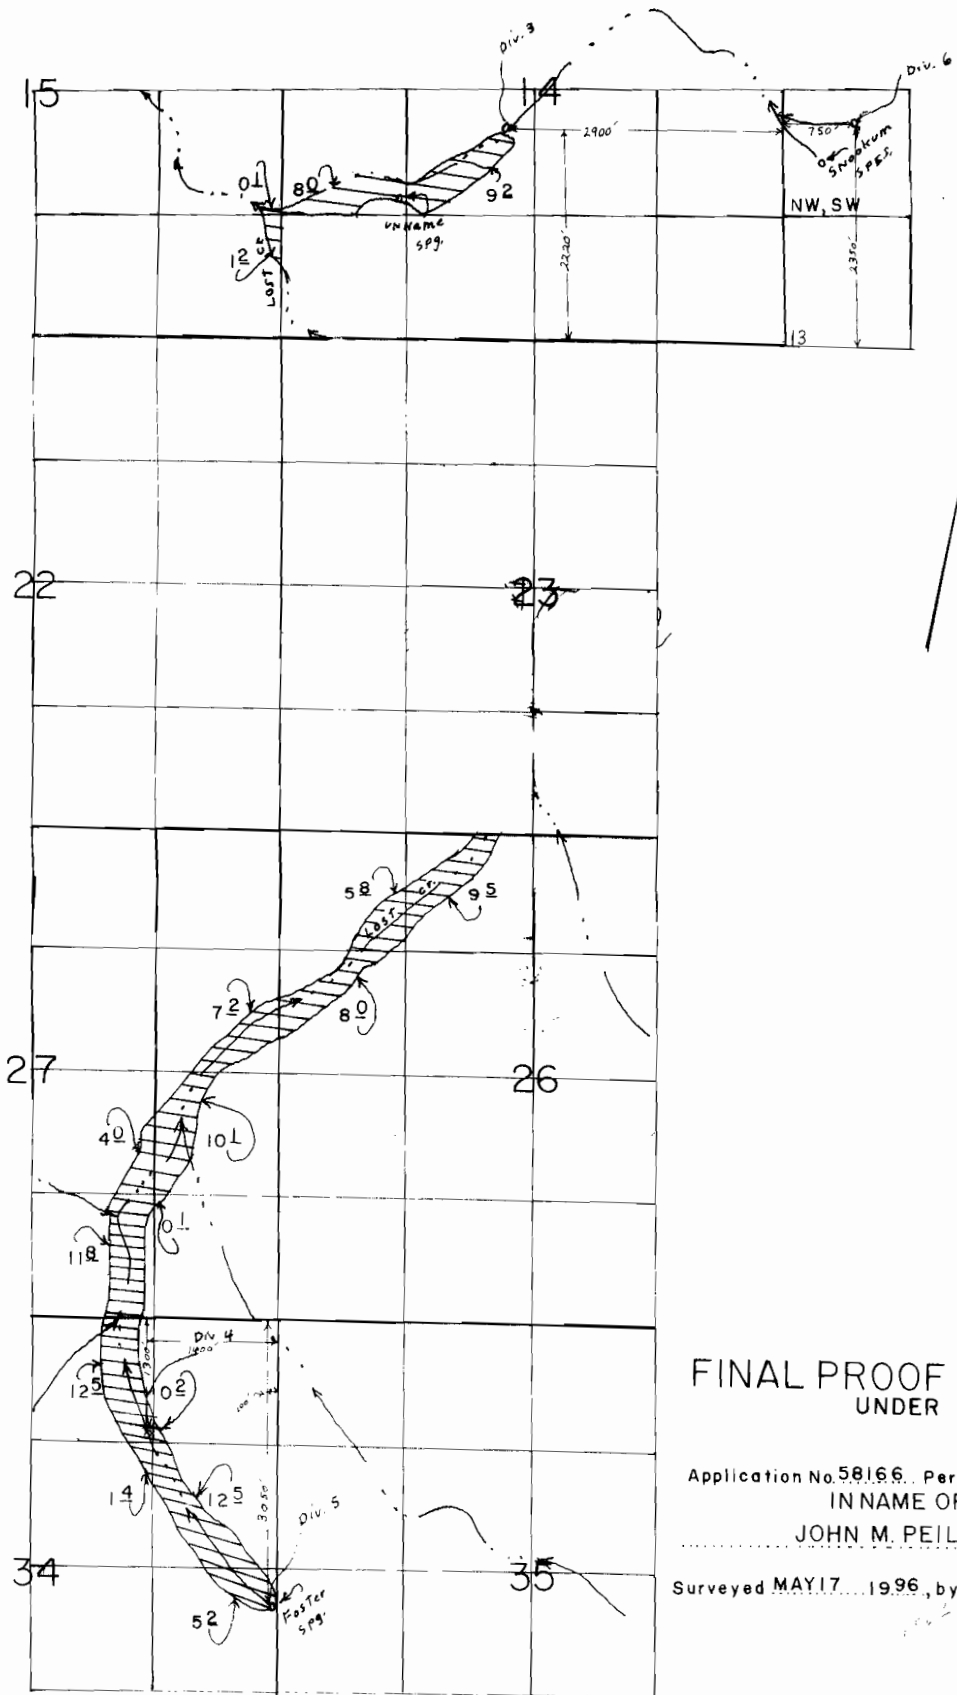

FINAL PROOF SURVEY
UNDER

Application No. 58166, Permit No. 46965
IN NAME OF

JOHN M. PEILA

Surveyed MAY 17, 1996, by R.M. SUTTERFIE