
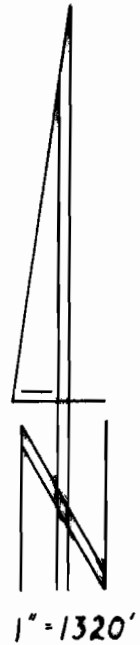


T. 7 N., R. 3 W., W.M.

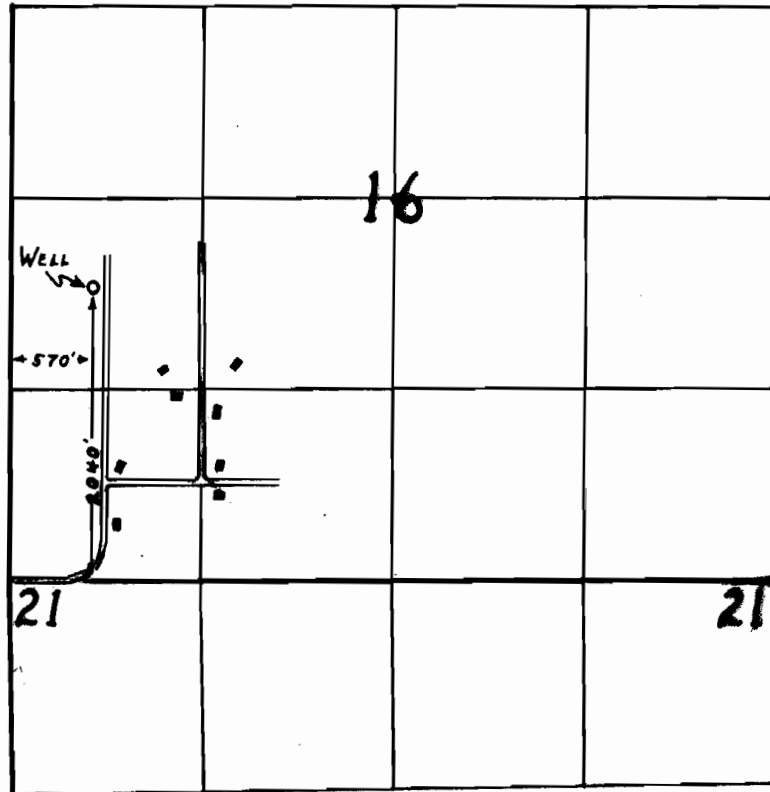

FINAL PROOF SURVEY

UNDER

Application No. G-9567 Permit No. G-9412
IN NAME OF

LOST CREEK HEIGHTS WATER ASSOCIATION

Surveyed JULY 15, 1992, by R.W. Klassen