
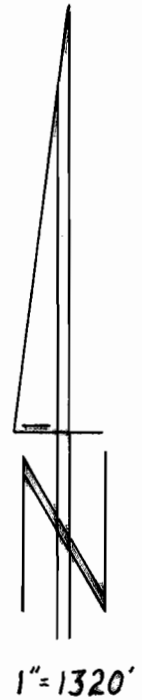


# T. 1 N., R. 2 W., W.M.

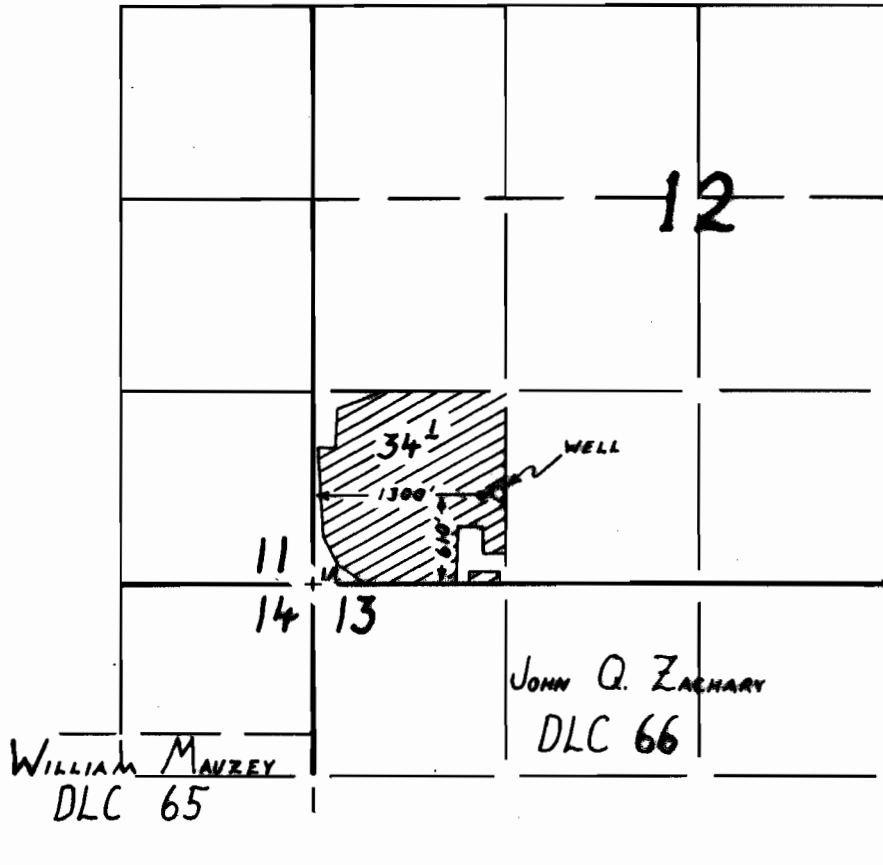

## FINAL PROOF SURVEY

UNDER

Application No. G-11636 Permit No. G-10766  
IN NAME OF

JEFF BODEN

Surveyed SEPTEMBER 6, 1992, by R.W. Klassen