
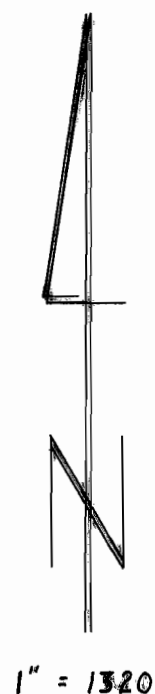


T 7S, R 1W, WM

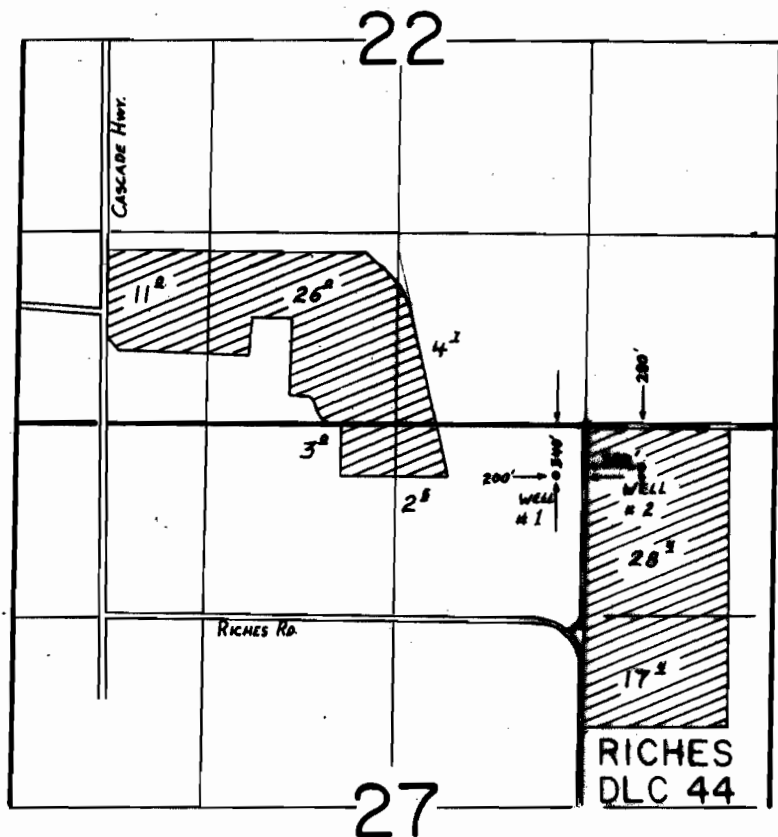

FINAL PROOF SURVEY
UNDER

Application No. G-11409 Permit No. G-10511
IN NAME OF

ROBERT L. RICHES

Surveyed JUNE 29, 1988, by Z. SALEM