


T. 5 S., R. 11 E., W.M.

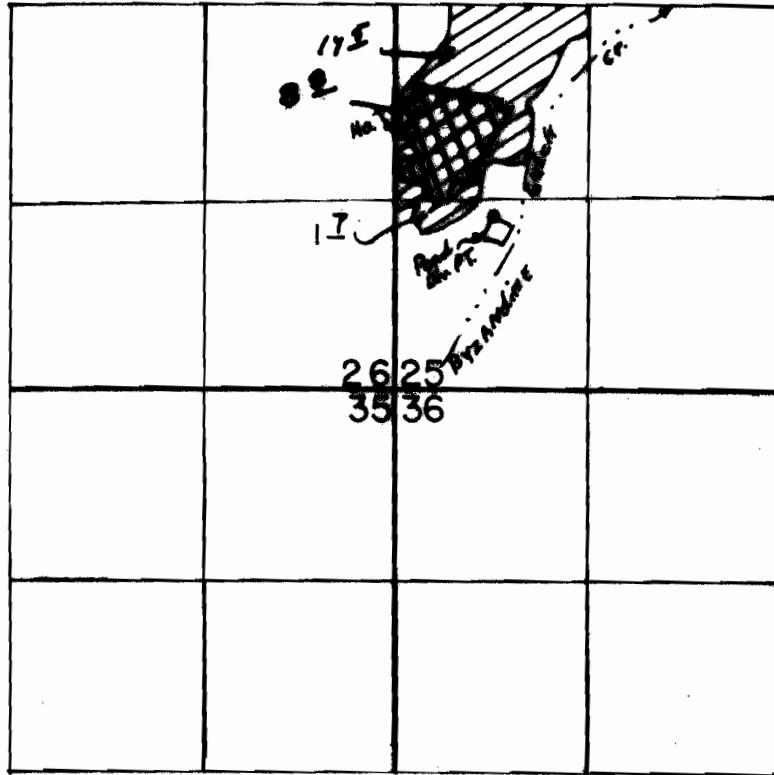

DIV. PT. LOC: 1180' N & 710' E FROM SW COR. OF SEC. 25.

 - PRIMARY

 - SUPPLEMENTAL

SCALE: 1" = 1320'

FINAL PROOF SURVEY UNDER

Application No. 55920. Permit No. 42253.....
IN NAME OF

GEORGE H. & SHARON HARMON..

Surveyed JULY 21 1995., by R.M. SUTTERFIELD

10/10/06 SWG

PHOTO SURVEY 41065-279-280C 11/13/95 RM