


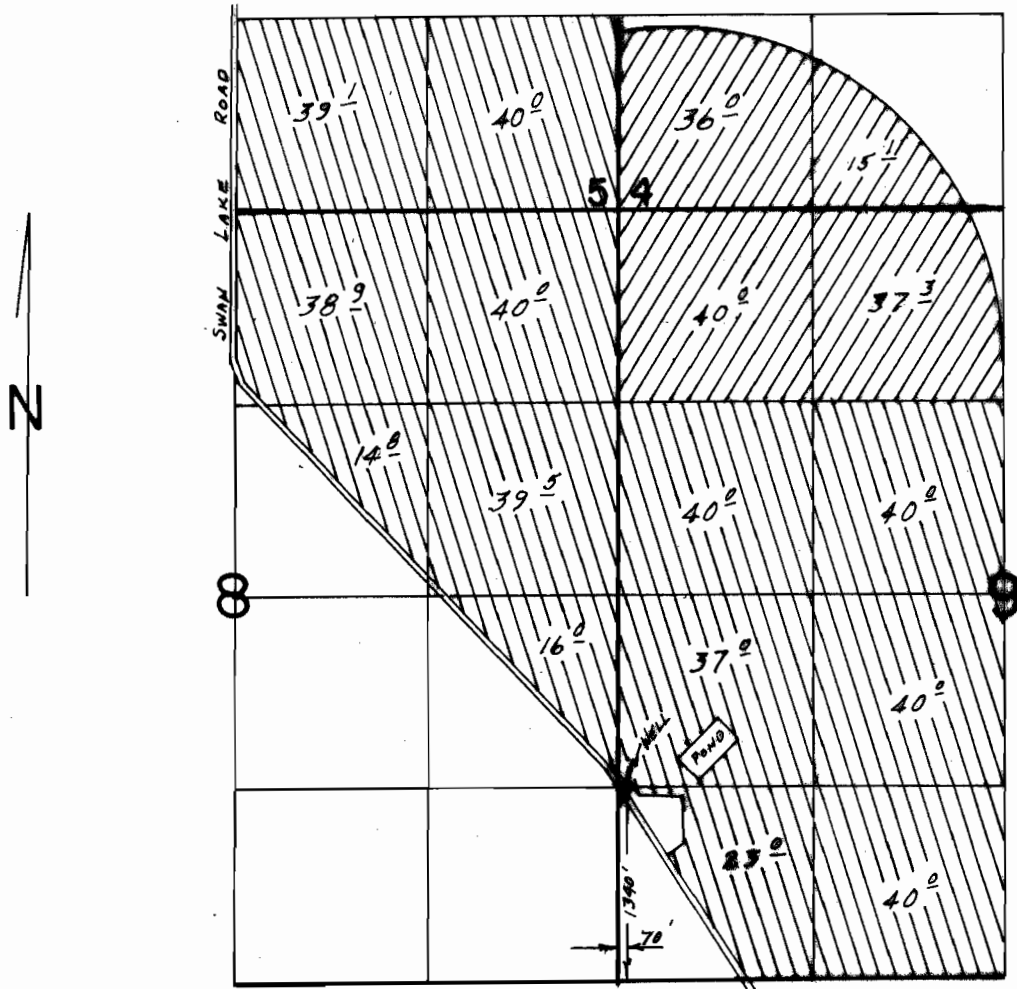

T. 38 S., R. 10 E., W.M.



SCALE: 1" = 1320'

-  Primary
-  Supplemental

FINAL PROOF SURVEY

UNDER

Application No. G-9339 Permit No. G-8625
IN NAME OF

Surveyed MAY 21 & 22, 1991, by B.W. BISHOP