


T.31S.,R.11E.,W.M.

RECEIVED

DEC 21 1994
WATER RESOURCES DEPT.
SALEM, OREGON

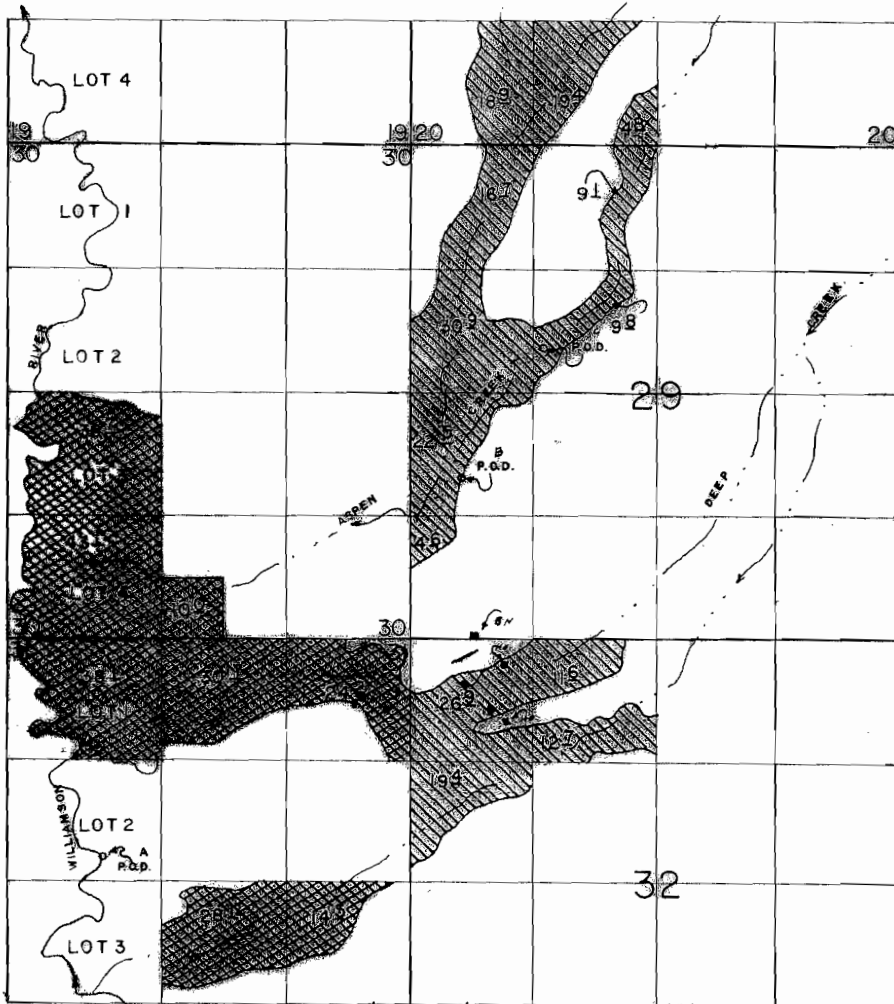

P.O.D. A, LOC 2350' S & 3250' W FROM NE COR. OF SEC 31.
 P.O.D. B, LOC: 1730' N & 550' E FROM SW COR. OF SEC 29.
 P.O.D. C, LOC: 2160' S & 1420' E FROM NW COR. OF SEC 29.

SCALE: 1"=1320'

FINAL PROOF SURVEY

APPLICATION NO. 37532 PERMIT NO. 27971
37573 27992

IN NAME OF

DONAL H. DEAN

SURVEYED MAY 25, 1994, BY R.M. SUTTERFIELD



PRIMARY
 SUPPLEMENTAL 227'

PHOTO 41035-178-64 R

T. 31 S.
R. 11 E.

19

Aspen Creek No. 1
Point of Diversion

SSP ARE 370.4
From map for Application for Permit 279711
OWRD Evt. 1, pg. 77

Deep Creek No. 3
Point of Diversion

Aspen Creek No. 2
Point of Diversion

MAP FOR POINTS OF DIVERSION
LOCATION ONLY

27

Deep Creek No. 4
Point of Diversion

Deep Creek No. 5
Point of Diversion




LEGEND

- Settlement Place of Use and Irrigated Acres
- 25 Irrigated Acreage Total within PLS Section Qtr-Qtr
- Ditches
- Boundary of Lands owned by Claimant that were former Indian Allotments

NOTES:

1. Deep Creek diversion points located as per OWRD adjudication survey maps and verified using aerial photos and USGS maps. Bearing and distance to diversion points determined graphically using AutoCAD unless noted otherwise.
2. Aspen Creek diversion points located from GPS coordinates supplied by Adkins Engineers. Bearing and distance to diversion points determined graphically by HKM using AutoCAD.

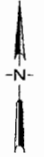

1 Inch = 1320 Feet (approx.)

Lot 3

Lot 4

Lot 1

This map is not intended to provide legal dimensions or locations of property lines.



Copyright © 2004 HKM Engineering Inc. All Rights Reserved.

• HKM Project No. 3M137.214 22-1 • N:\Klamath\CLAIMS\CLAIM-22\SettlementClaim22\Gry/Tones.dwg BJ • August 16, 2004

KLAMATH BASIN WATER RIGHTS ADJUDICATION
CLAIM NO. 22 - SETTLEMENT
CLAIMANT: DONAL DEAN

EXHIBIT
1