


T. 35 & 36S., R. 10E., W.M.

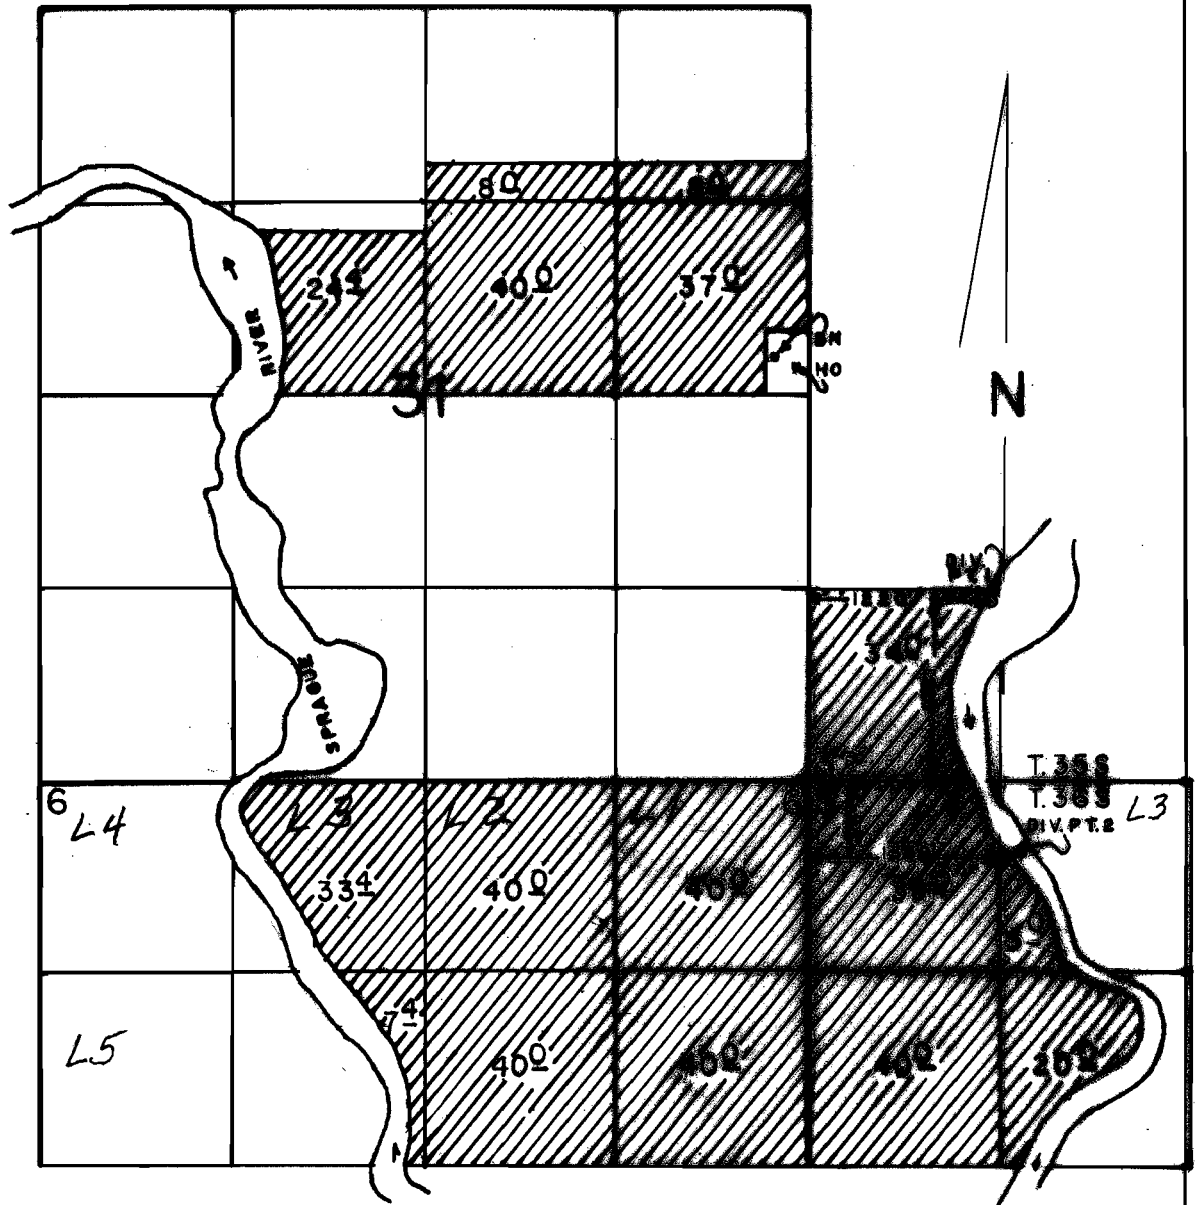

FINAL PROOF SURVEY

UNDER

Application No. 51570 Permit No. 37151
IN NAME OF

SCALE: 1" = 1320'

JAMES E. & TRACY LEA GOULD

Surveyed MAY 11, 1994, by R.M. SUTTERFIELD

456 2