


T. 29 S., R. 17 E., W.M.


FEB - 8 1994

WATER RESOURCES DEPT
SALEM, OREGON

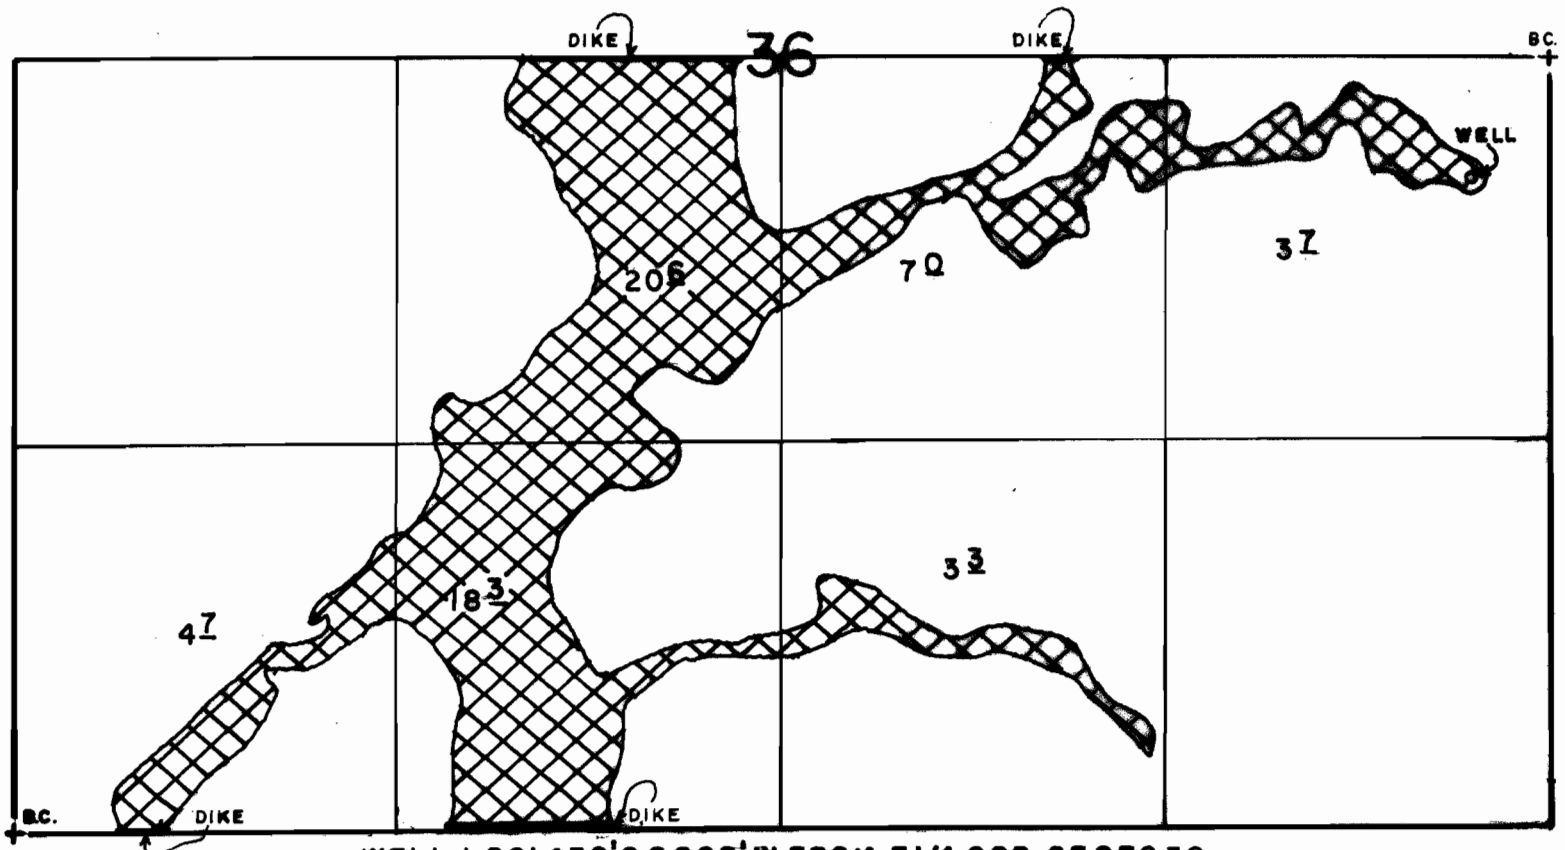

WELL LOC: 430'S & 280' W FROM E1/4 COR. OF SEC 36.

SCALE: 1" = 660'

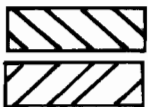

IRRIGATION

WILDLIFE

FINAL PROOF SURVEY

UNDER

Application No. G-11045 Permit No. G-10249
IN NAME OF

GILBERT B. KOHFIELD & J. ED LONG & DAVID ROSE

Surveyed AUG 25, 1993, by R.M. SUTTERFIELD

