


T.36S.,R.13E.,W.M.

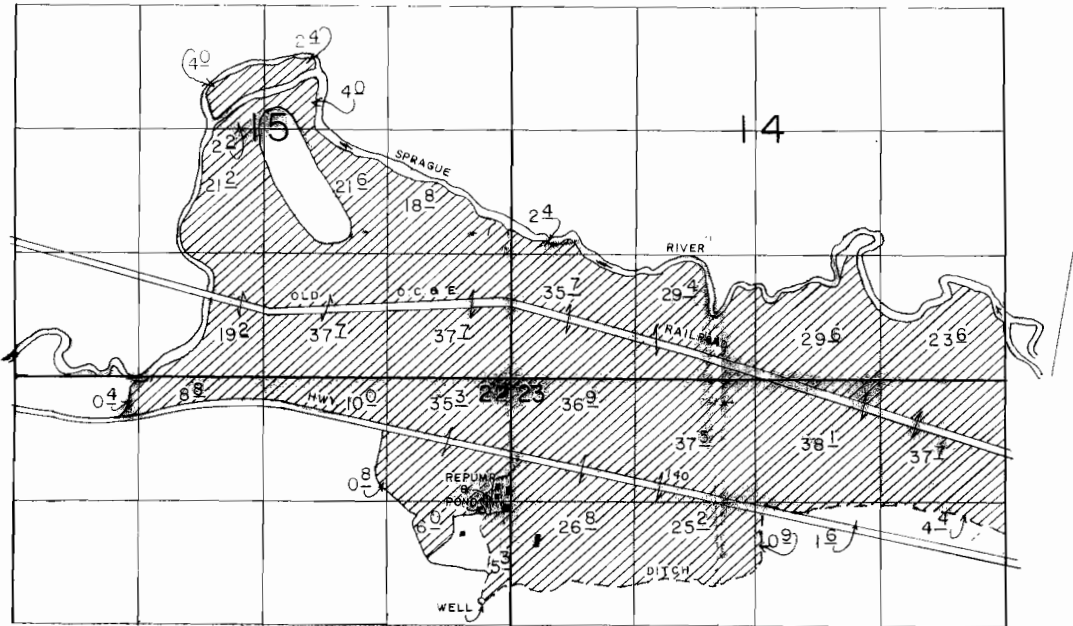

WELL LOC: 2570'S & 300'W FROM NE COR. OF SEC 22.

SCALE: 1" = 1320'

FINAL PROOF SURVEY  
UNDER

APPLICATION NO. G-6266 PERMIT NO. G-5222  
IN NAME OF

565 3 ac

RIVER SPRINGS RANCH

SURVEYED JULY 27, 1994, BY R.M. SUTTERFIELD