


# T. 40 S., R. 12 E., W.M.

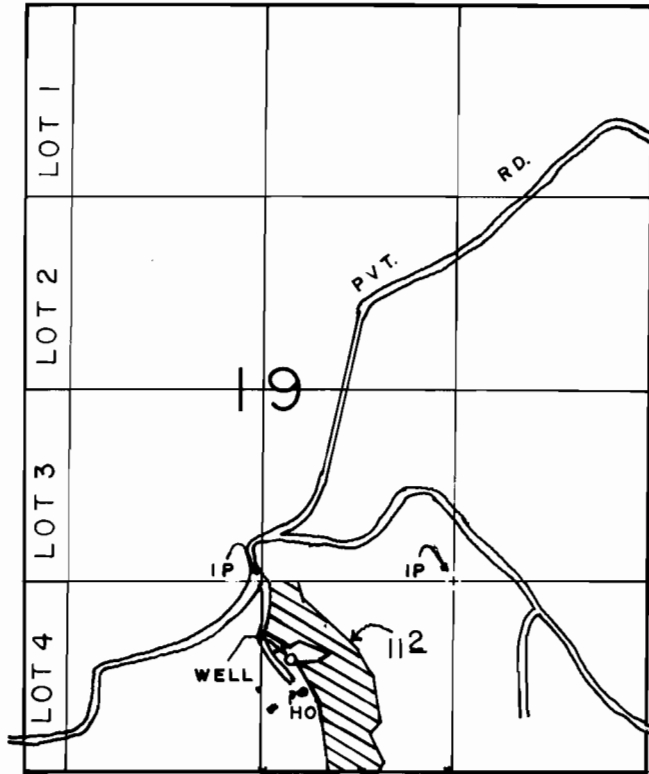

WELL LOC: 550'S. & 200'E. FROM NW COR. SW 1/4 SE 1/4 SEC 19

SCALE: 1" = 1320'

## FINAL PROOF SURVEY

UNDER

Application No. G-9207 Permit No. G-8529  
IN NAME OF

ANDREW C. GASKIN

Surveyed JULY 30., 1992, by B.W. BISHOP