


T. 6 S., R. 1 E., W.M.

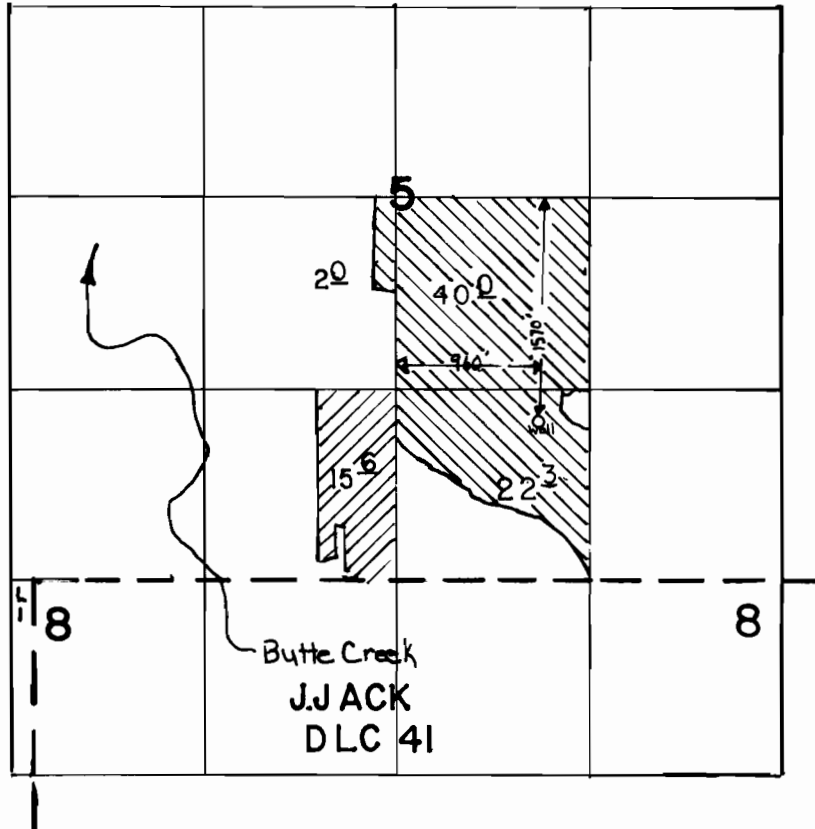

- Primary
- Supplemental

FINAL PROOF SURVEY

UNDER

Application No. G-11607 Permit No. G-10683
IN NAME OF

GREG WHITE

Surveyed MARCH 29, 1991, by R.W. KLASSEN