


T. 29 S., R. 4 W., W.M.

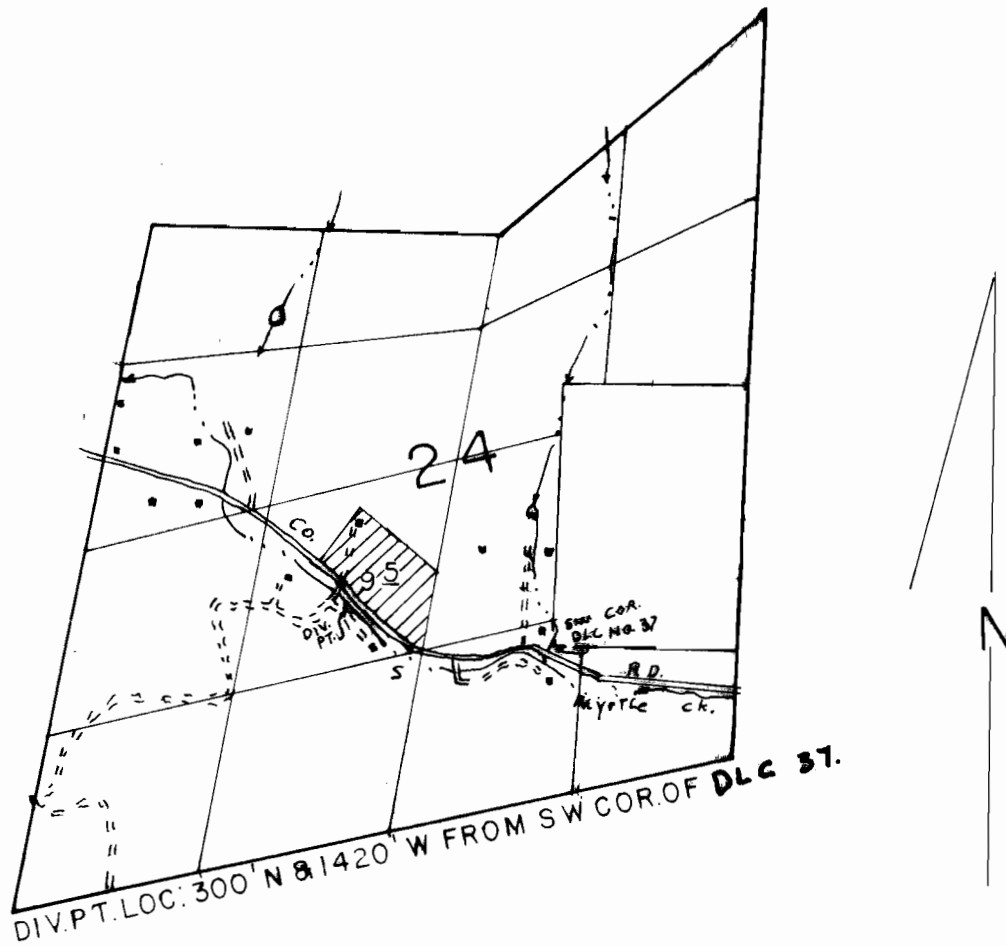

SCALE: 1"=1320'

FINAL PROOF SURVEY
UNDER

Application No. 64995 Permit No. 47721
IN NAME OF

.....STEVEN D. POTTER.....

Surveyed JUNE 3 1997, by R.M. SUTTERFIELD

10/12/06 JWG