


T. 2 N., R. 3 W., W.M.

SECTION 35

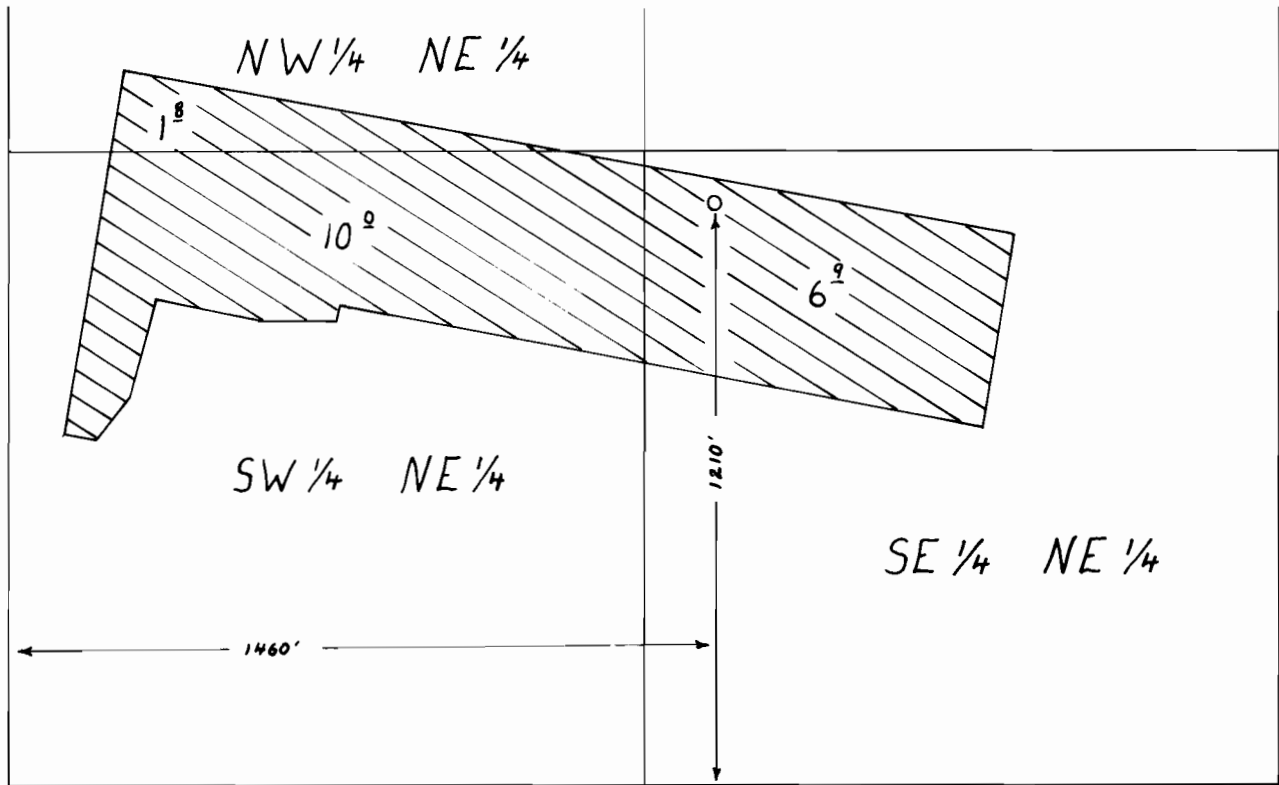


FINAL PROOF SURVEY

UNDER

Application No. G-11670 Permit No. G-10777
IN NAME OF

TERRY R. BEHRENS

Surveyed NOVEMBER 6, 1992, by R.W. Klassen

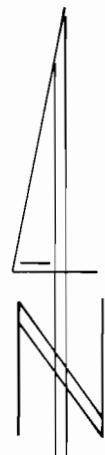

1" = 400'