


T. 1 S., R. 4 E., W.M.

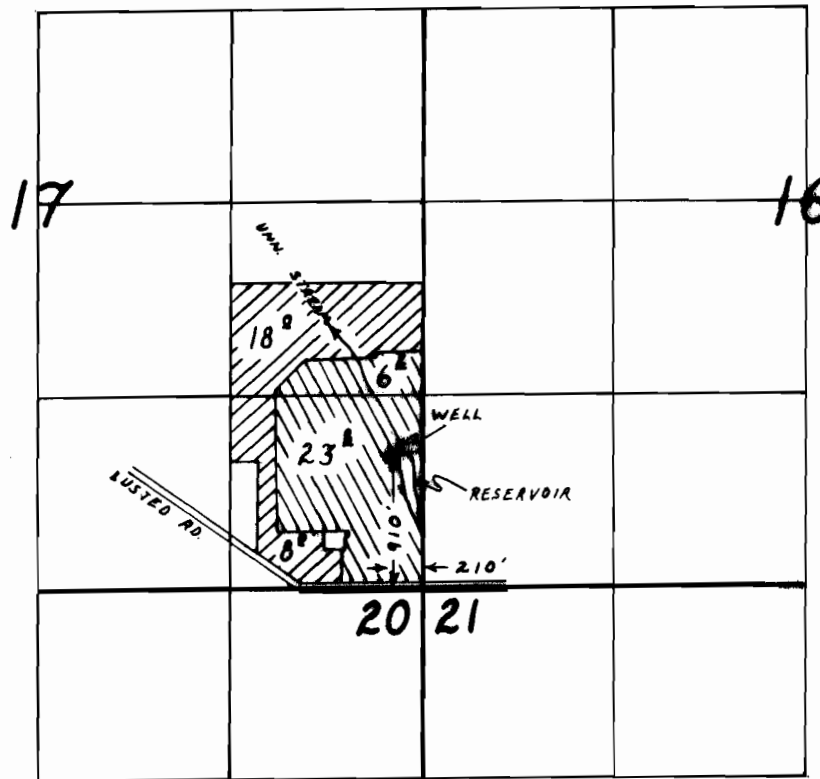

 PRIMARY 28617
SUPPLEMENTAL G 8362
 PRIMARY G 8562

FINAL PROOF SURVEY

UNDER

Application No. G-8562, R-28616, 28617 Permit No. G-8029, R-1702, 23327
IN NAME OF

DARYL M. LUNDBOM

Surveyed August 1, 1991, by R.W. Klassen