


T. 7 S., R. 2 W., W.M.

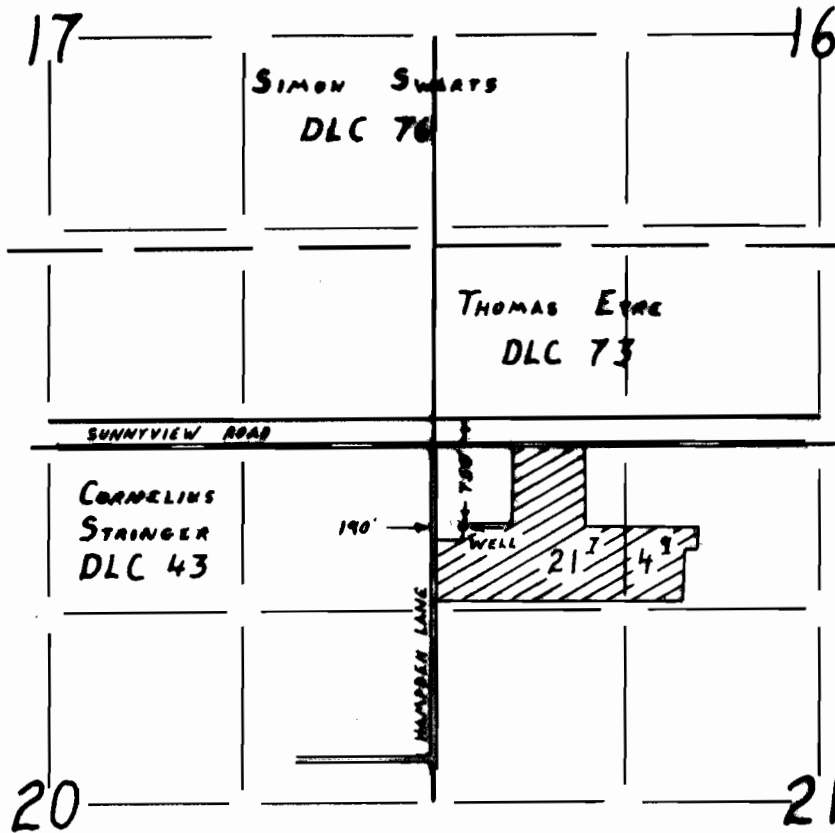

FINAL PROOF SURVEY

UNDER

Application No. G-11538 Permit No. G-10628
IN NAME OF

E. HAROLD SCHIPPOREIT

Surveyed MARCH 19, 1991, by R.W. Klassen