


T.39 S., R.19 E., W.M.

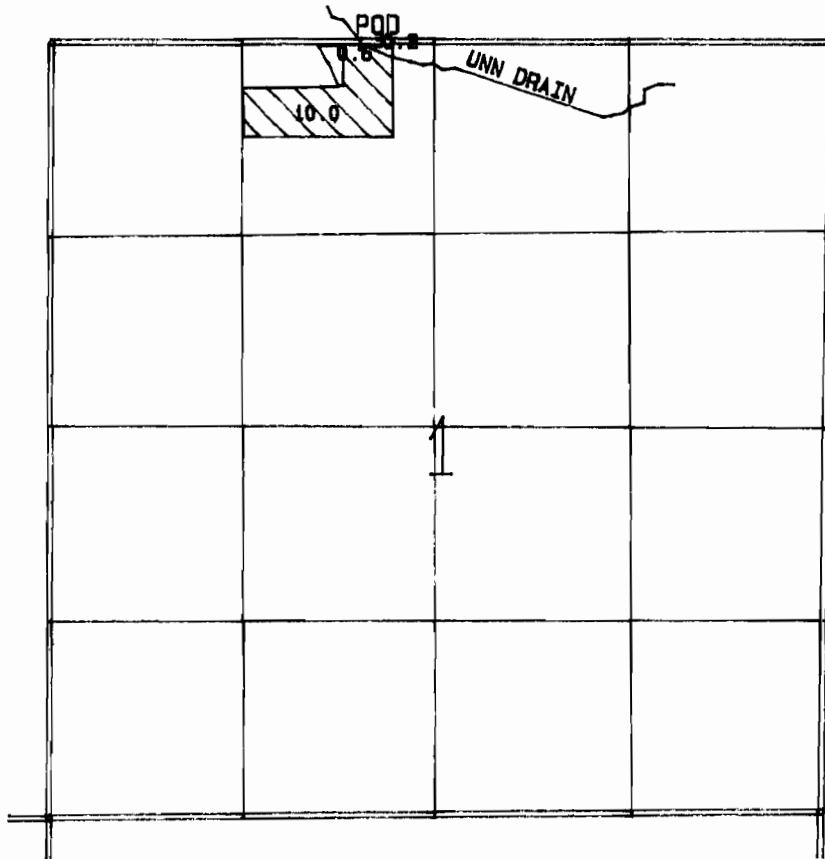

POD LOCATED 30 FT. S. AND 2120 FT. E. FROM NW COR. SEC. 1

SCALE: 1 = 1320

FINAL PROOF SURVEY

UNDER

Application No. 63783 Permit No. 46953

IN NAME OF

ARCHIE C. OSBORNE

Surveyed Oct.16, 1987 By M. J. MATTICK

Photo: 379-88A LN