
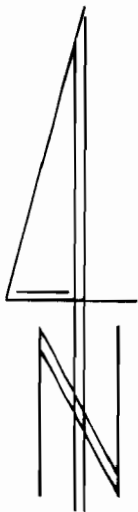


T. 3 S., R. 3 W., W.M.

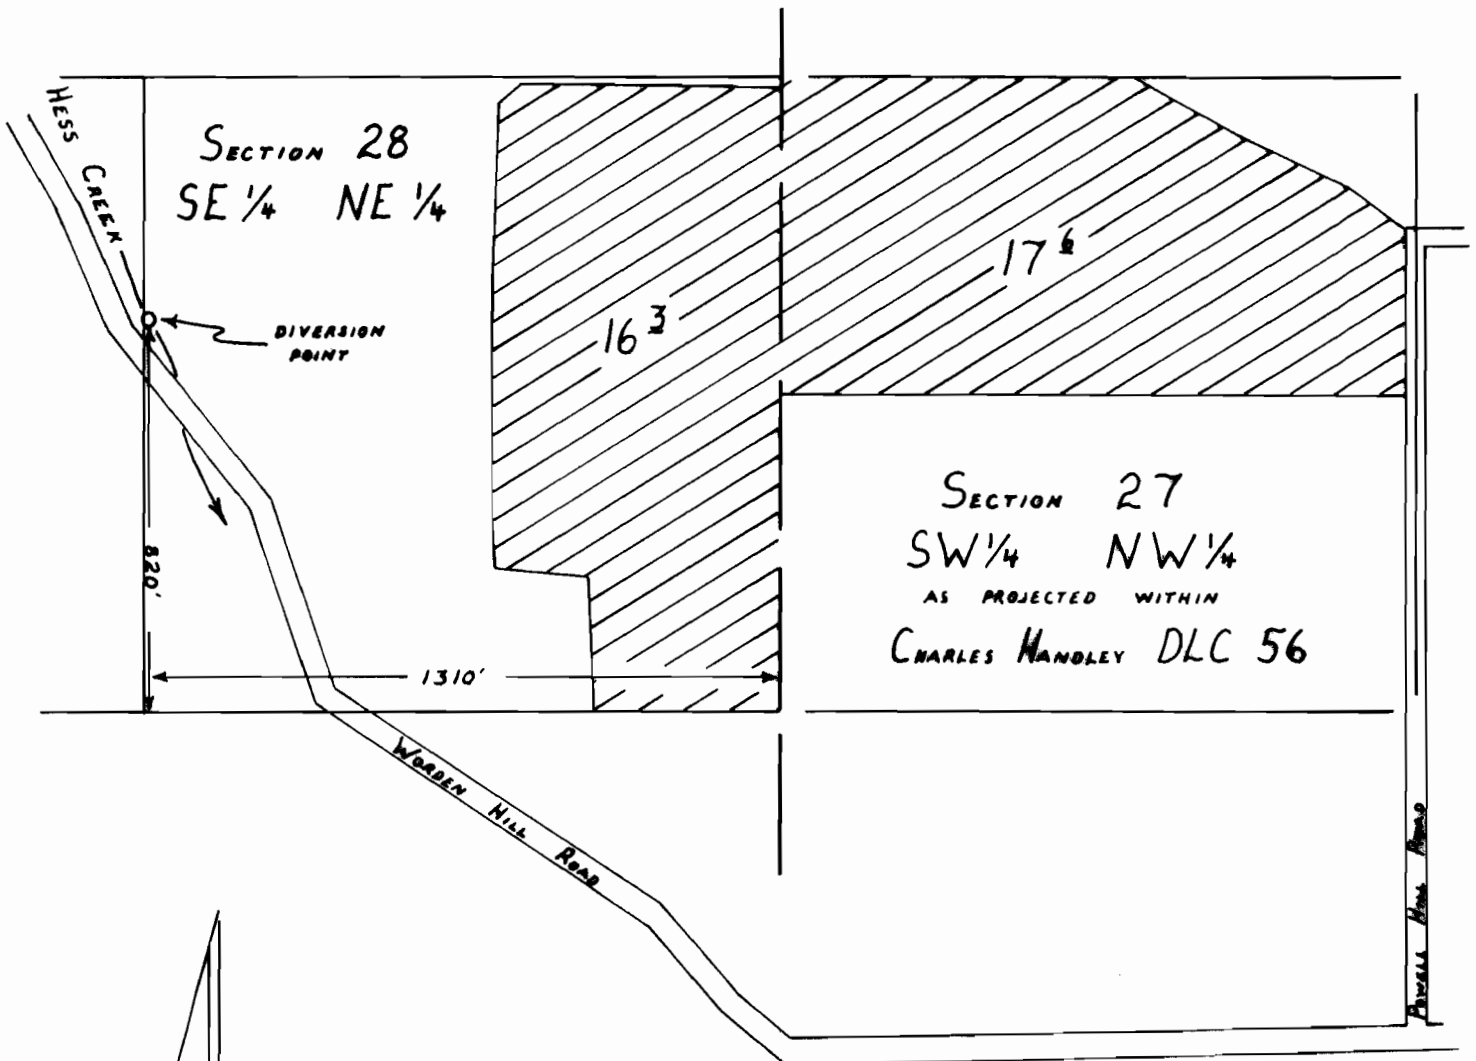

1" = 400'

FINAL PROOF SURVEY

UNDER

Application No. 68647 Permit No. 49654

IN NAME OF

G. ALLAN & HELEN G. SEWARD

Surveyed DECEMBER 9, 1991, by R.W. Klassen