T. 5 S., R. 3 W., W.M.

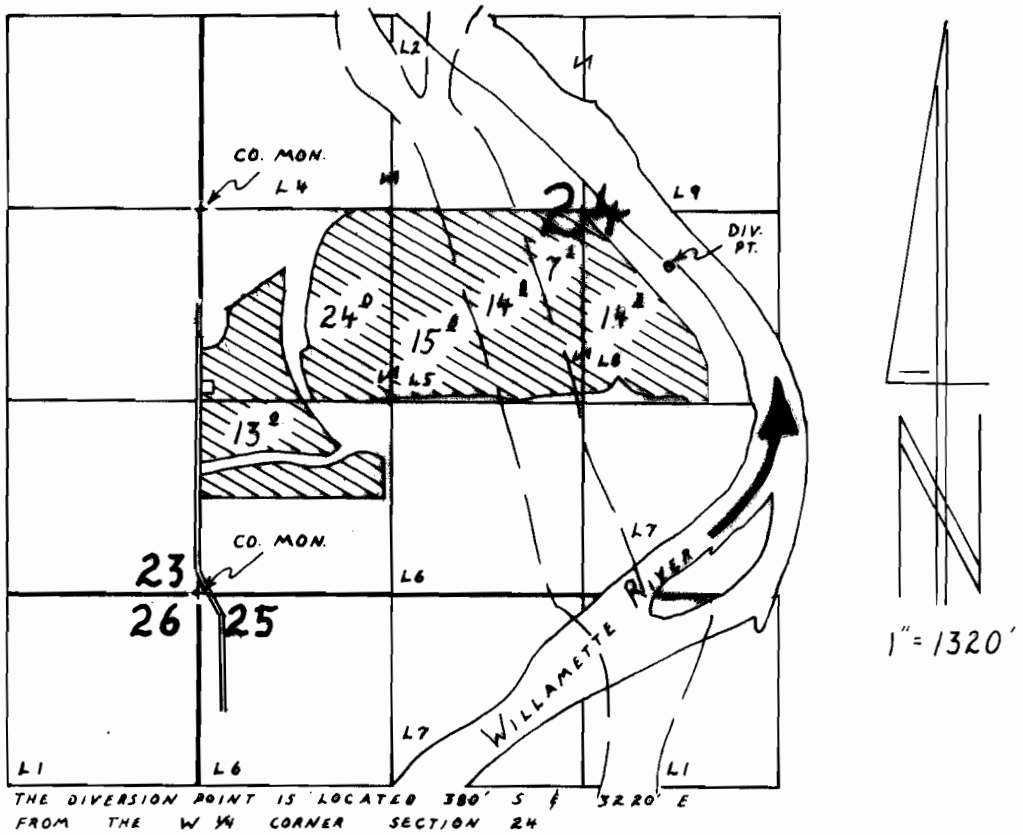

FINAL PROOF SURVEY

UNDER

Application No. 68712 Permit No. 49699

IN NAME OF

CHARLES SMITH STEPHENS

Surveyed JUNE 10, 1993, by R.W. Klassen

4/067 489.123R RWK 10/1/93