


1" = 400'

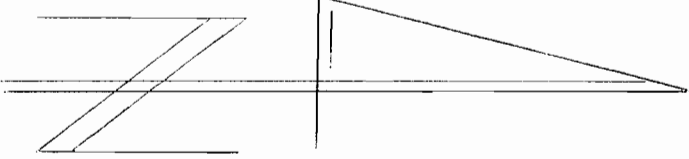

25  
30

36  
31  
100  
44.46 Ac.  
3980

Lot 1

# FINAL PROOF SURVEY

UNDER

Application No. G 9609, Permit No. G 9335

IN NAME OF

GEORGE J. DODLEY, III

Surveyed Oct 2 1991, by R W KLASSEN

Lot 2

N.W. COR  
D.L.C. 57  
1900  
42.06 Ac.

1800  
30.00 Ac.

2 3

SEE MAP

SEE MAP

SEE MAP 10 4 30

TANYA PLACE

04398

10

4

10

4

31BA

LESSIE PLACE

04397

SEE MAP

31BB

10

4

31BD

SEE MAP

31BC

10

4

31BA

RELOCATED

SW COR  
D.L.C. 58  
760'

LORRI PLACE

04396

700'  
8.46 Ac.

1600  
20.43 Ac.

62 Ac

1200  
2.99 Ac

1400  
2.49 Ac

1000  
1.18 Ac

990  
0.85 Ac

800  
1.56 Ac

270  
1.56 Ac

RIVENDELL (PVT)  
1300 Ac.  
0.75 Ac.

OLD PACIFIC HWY 66 (M 66)

BETH (PVT) LANE

900  
9.02 Ac.

8793

205  
68,674 Ac.

800  
1.56 Ac.

51' 23" 48" E 1725' 19"  
100' 524"  
M. B. H. E. R. O. V. I. N.  
45-2821

1421' 12"  
11' 15" 22"  
1602

1400  
1.36 Ac.

15390

602

8555

501

35,624 Ac.

648 92'

70' 70"

528