T. 1 S., R. 2 W., W.M.

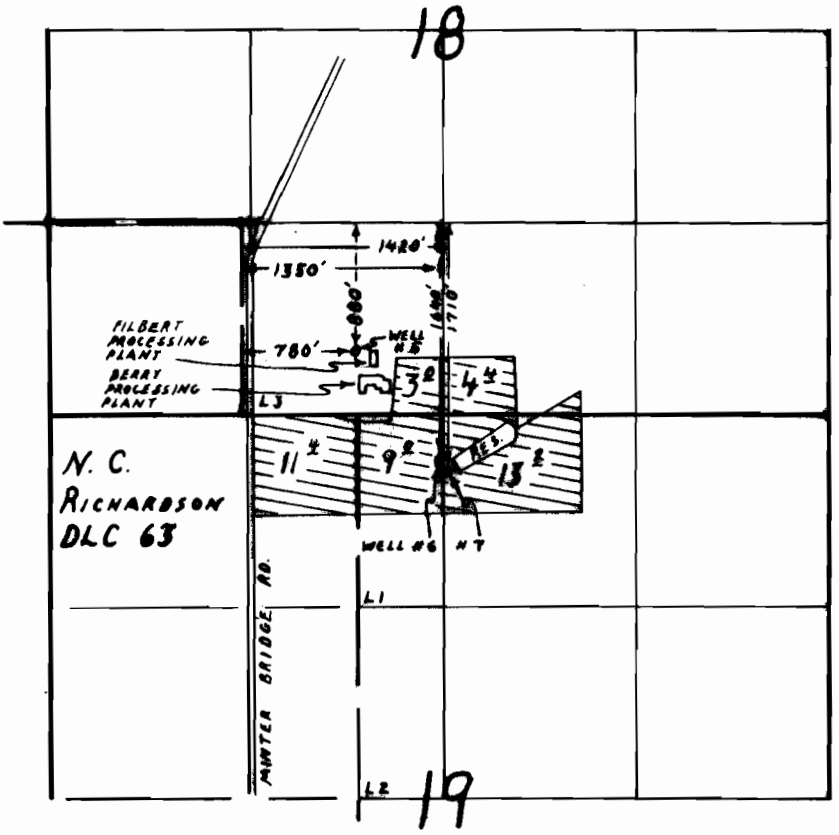

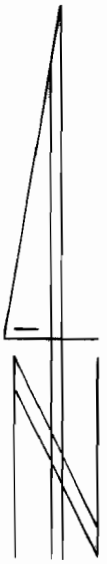

1" = 1320'

FINAL PROOF SURVEY

UNDER

Application No. G-11597 Permit No. G-10711

IN NAME OF

OREGON BERRY PACKING COMPANY

Surveyed July 14, 1993, by R.W. Klassen

41067 589 63L RWK 10/26/93