


T.30S.,R.17E.,W.M.

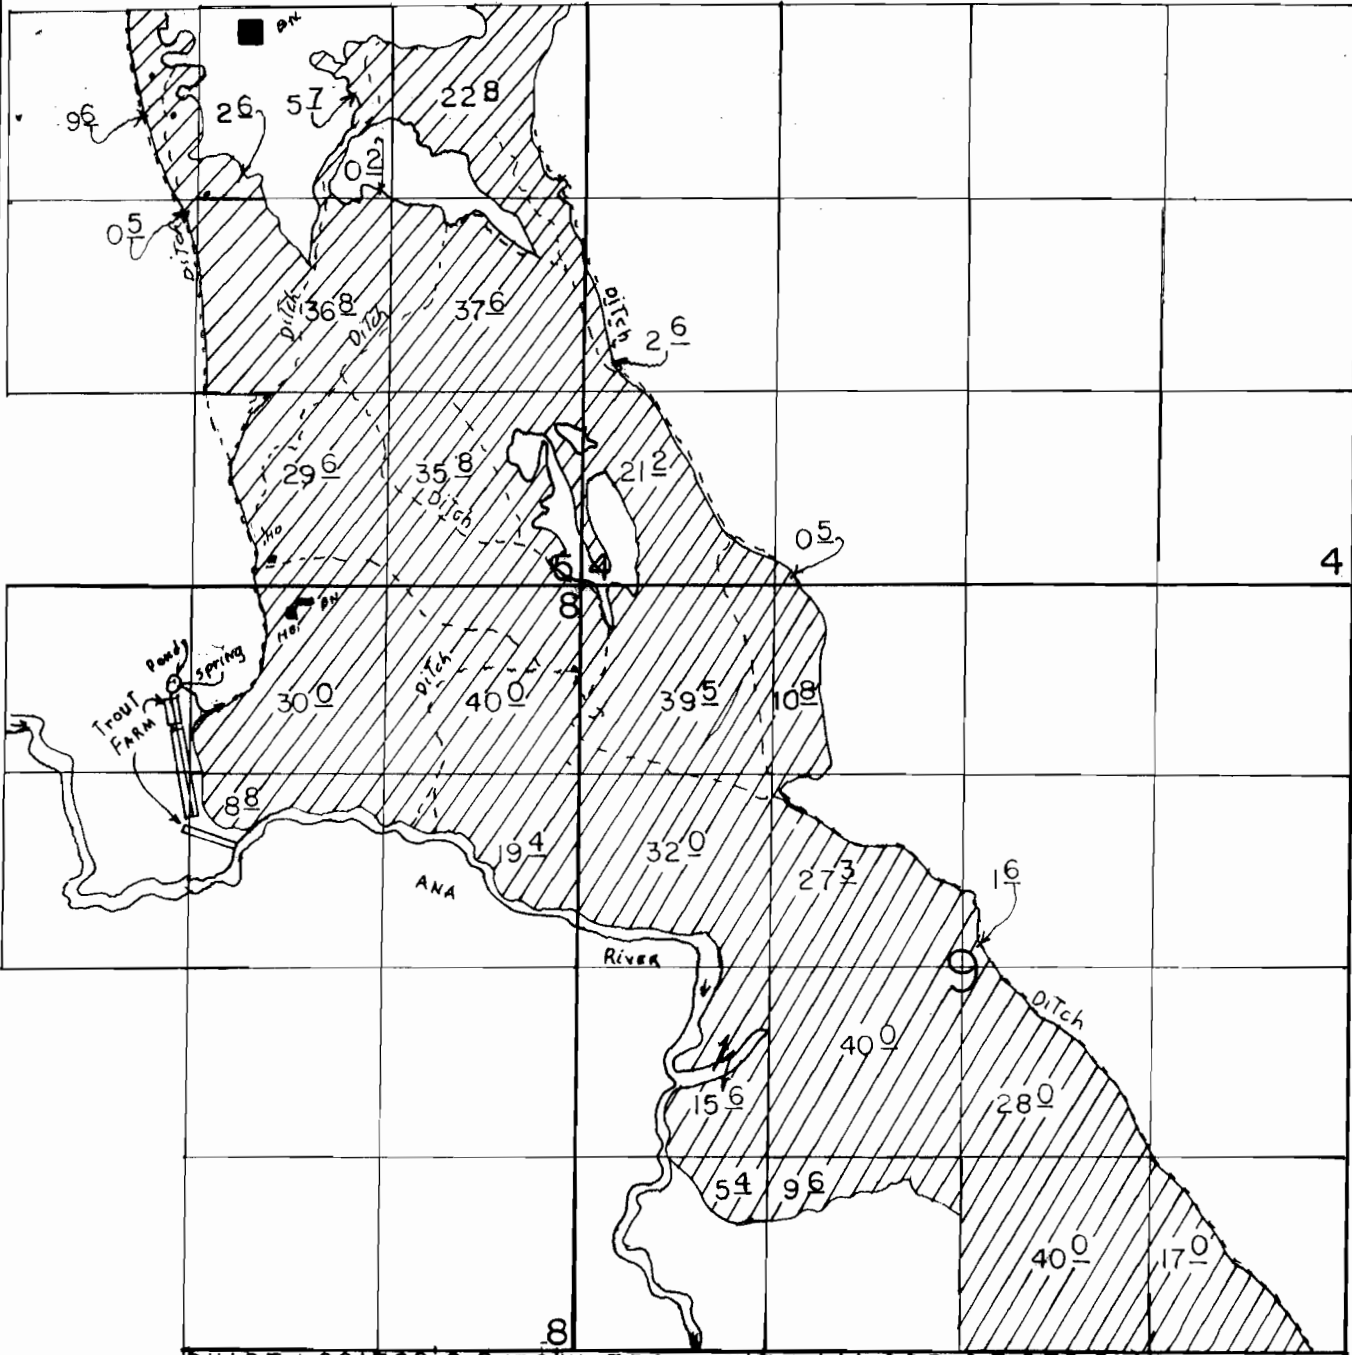

DIV. PT. LOC: 780' S & 170' W FROM THE N1/4, COR. OF SEC 8.

SCALE 1" = 1320'

FINAL PROOF SURVEY UNDER

61505 46063 - TROUT FARM
Application No. 57451. Permit No. 43260... - IRRIGATION

IN NAME OF
FIRST INTERSTATE BANK OF OREGON &
EUAN CARLON, DBA CARLON CATTLE CO.

Surveyed MAY 29 19.97, by R.M. SUTTERFIELD

570 3/4