
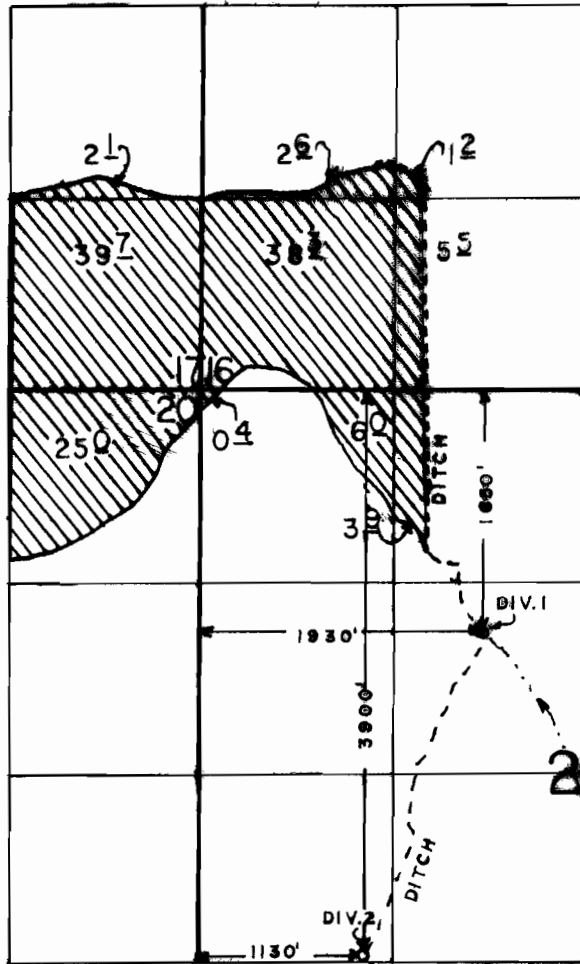


T.36S., R.21E., W.M.

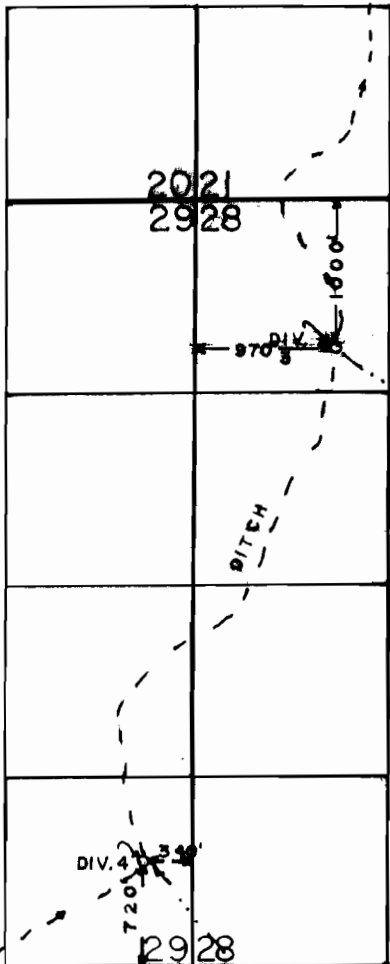

SCALE: 1" = 1320'

FINAL PROOF SURVEY

UNDER

Application No. 60716 Permit No. 46294
IN NAME OF

124.7 AC

DONALD SIMMS

Surveyed SEPT 7, 1994, by R.M.SUTTERFIELD