


T. 1 S., R. 4 E., W.M.

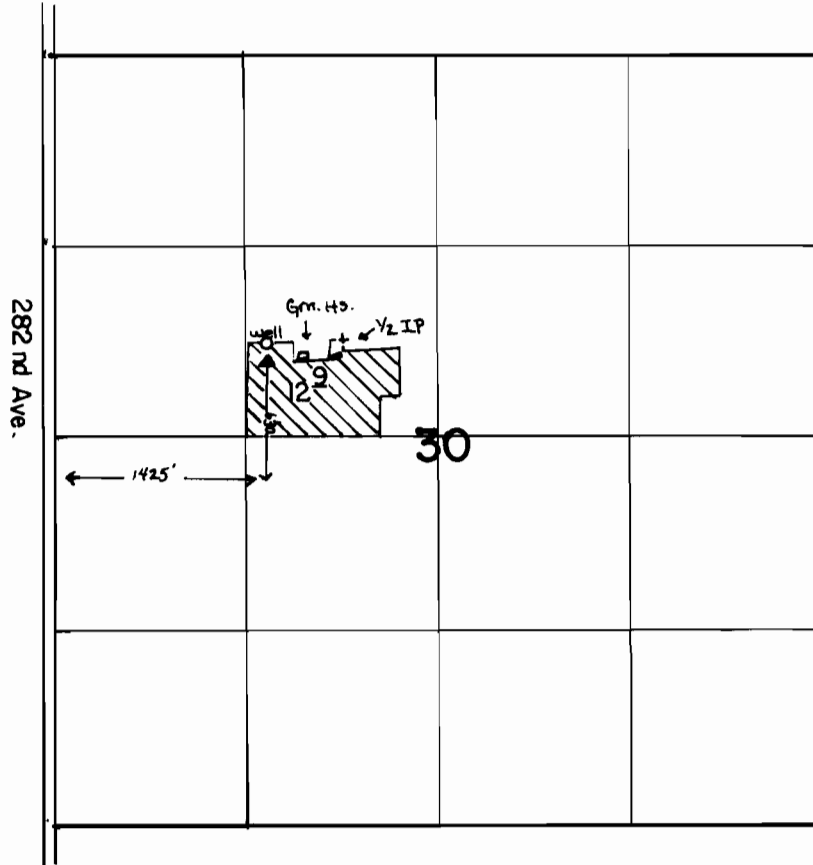

FINAL PROOF SURVEY

UNDER

Application No. G-11548 Permit No. G-10745
IN NAME OF

TIMOTHY G. FISHER

Surveyed APRIL 9, 1991, by R.W. KLASSEN

KC 2/13

PTS w/FF