




T. 39 S., R. 24 E., W.M.

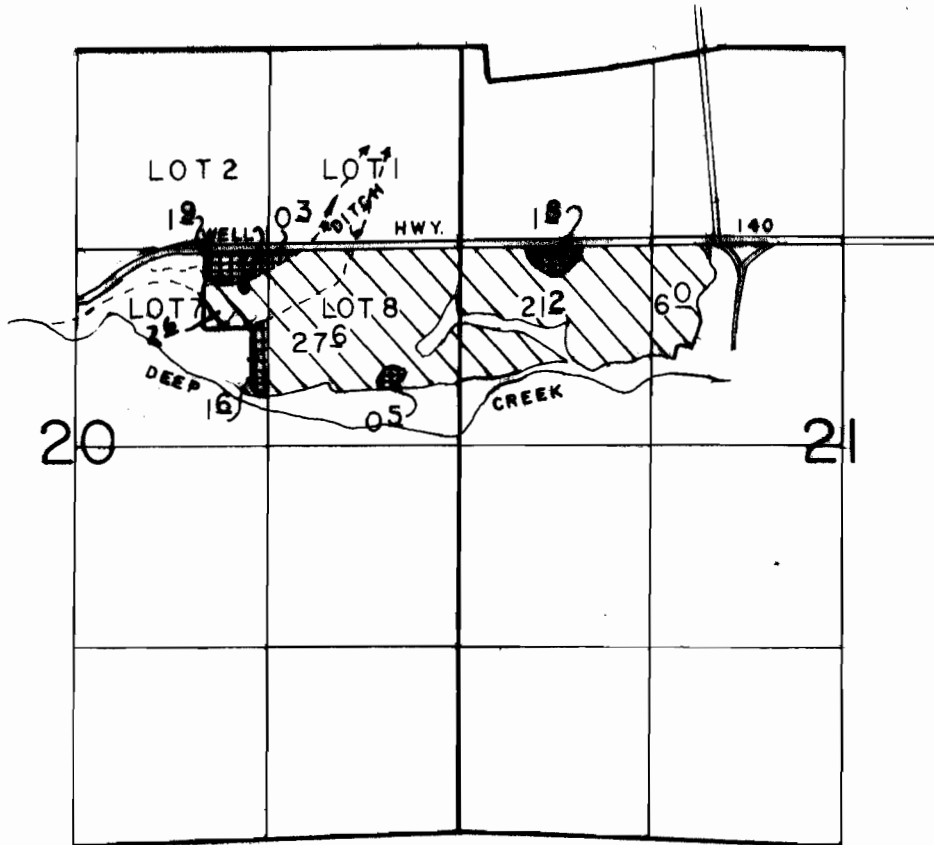

WELL LOC: 1620'S & 1500'E FROM NE COR. OF SEC 20.

-  SUPPL. WELL
-  PRIM. WELL

SCALE: 1" = 1320'

FINAL PROOF SURVEY

UNDER

Application No. G-10448 Permit No. G-9613
IN NAME OF

NOLAN AND LOIS GRIENER

Surveyed NOV. 27, 1990, by B.W. BISHOP