


# T. 40 S., R. 17,18 E., W.M.

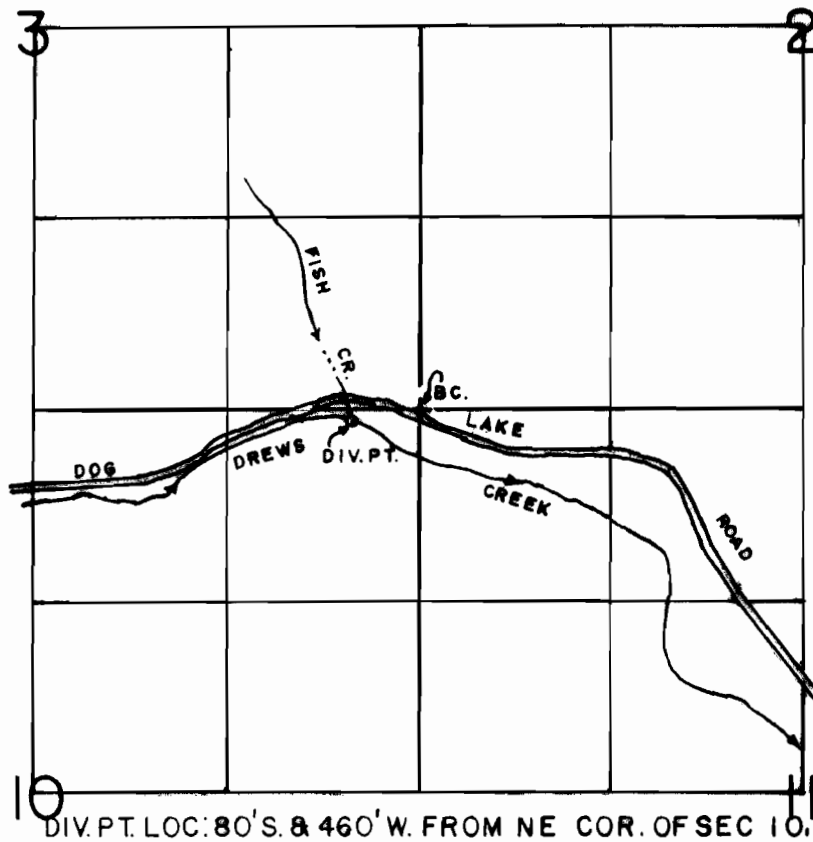

SCALE: 1" = 1320'

## FINAL PROOF SURVEY

UNDER

Application No. 59984 Permit No. 50482  
IN NAME OF

U.S. FREMONT NATIONAL FOREST

Surveyed APRIL 29, 1992, by B.W. BISHOP